

KANSAS


Stafford

FORM 51 5M BRIX

Section 6 Township 23 Range 12W

Well No. #1 Metz

Company Hinkle Oil

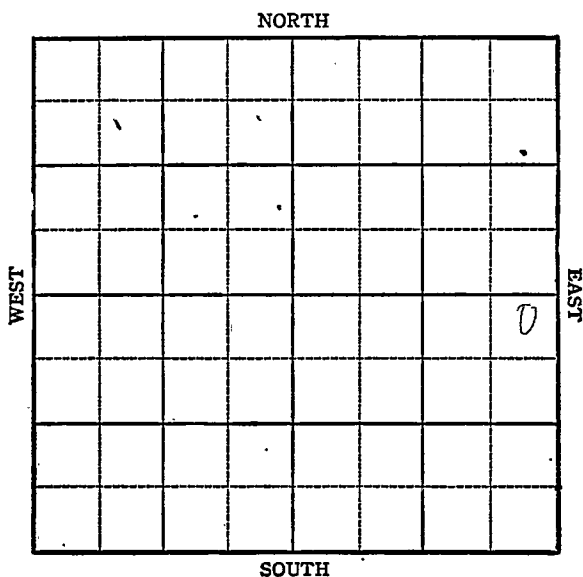

KANSAS

Sec. 6 Twp. 23 R. 12W

Well No. #1 Metz Farm

Hinkle Oil Company


Wildcat

330 Ft. from N. Line

 Ft. from S. Line

330 Ft. from E. Line

 Ft. from W. Line

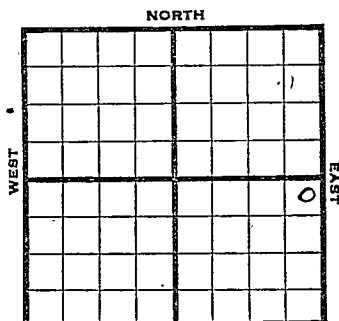

Stafford NE SE Elev. 1851 SOUTH

1944

R E P O R T

11/29 Loc.
12/6 Cellar
12/14 RUR
12/21 10" @ 225
Anhy 655
Dr1g. 1600'
12/29 Dr1g. 2615'

1945

1/10 Simp Sh 3707
Arb 3768
TD 3816

ABANDONED


Pool Name WildcatMap No. 47 Sec. 6 Twp. 23 R. 12WWell No. 1 MetzHinkle Oil Company

FIRST REPORT

Contractor

NE SE

SECTION PLAT

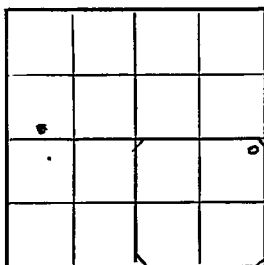330 Ft. from N. Line Ft. from S. Line330 Ft. from E. Line Ft. from W. Line

Sta "for d

Location XRig up

Drilling and Remarks:

RECORD

Cased in., ft.Sand Gas Oil Total Depth

PRODUCTION

1st 24 hrs. Nat. 1st 24 hrs. after shot Gas Cu. Ft.Dry Hole Abandoned

Date

NOV 29 1911S. J. LEWIS

Scout

Pool Name WildcatMap No. 47 Sec. 6 Twp. 23 R. 12WWell No. 1 MetzHinkle Oil

Company

ABANDONED

Contractor

NE SE

SECTION PLAT

330 Ft. from N. Line Ft. from S. Line330 Ft. from E. Line Ft. from W. Line

			0

StaffordLocation Rig up

Drilling and Remarks:

*Comp Sh 3767**Cr 48768*

RECORD

Cased in., ft.Sand Gas Oil Total Depth 3816

PRODUCTION

1st 24 hrs. Nat. 1st 24 hrs. after shot Gas Cu. Ft.Dry Hole Abandoned

Date

JAN 10 1945 19S. J. LEWIS Scout