


Section 6 Township 23 Range 13W

Well No. #1 Miller

Company Petroleum Inc.

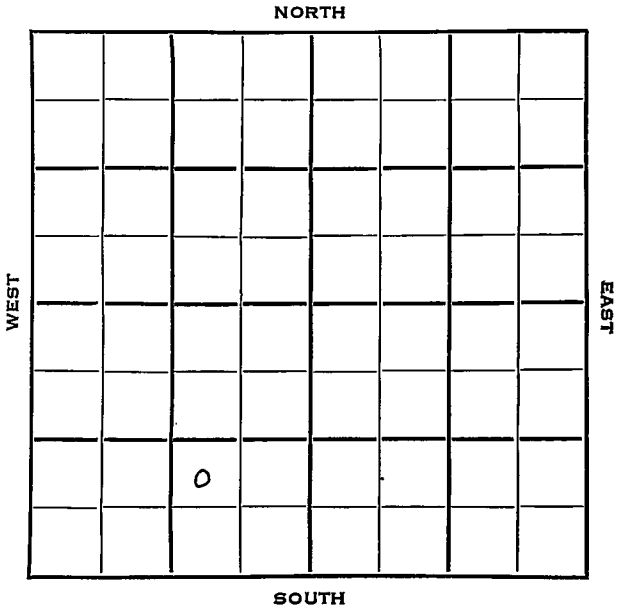

Stafford

Sec. 6 Twp. 23 R. 13WWell No. #1 Miller FarmPetroleum Inc. CompanyGarvey ContractorWildcat


_____ Ft. from N. Line

990 _____ Ft. from S. Line990 _____ Ft. from E. Line

_____ Ft. from W. Line

NW SE SW

Sunray Farmout SW/4

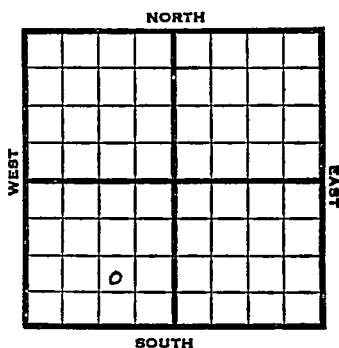

1953 Elev. 1925' REPORT

- 2/18 Spudding Date 2/14/53
8" @ 254 Anhy 813 Drlg. 1433
- 2/26 Heeb 3342 Br Li 3471 Lans 3489 DST 3517-70 1 Hr. 60' O&GCM 30' O&GCM wtry M. 60' SO&GCM 1050# DST 3628-60 3/4 hr. 12' V SO&GCM off DST 3666-3703 3/4 hr 5' M. V 3811 Simp 3865 DST 3818-67 40 mins. 12' M 125# Drlg. 3871
- 3/4 Spud 2-14-53
D&A
TD 3946
8" @ 254
Anhy 813, Heeb 3342, Br lime 3471, Lans 3489
DST 3517-70, opn 1 hr., rec. 60' o & gcm, 30' o & gcm, 60' so- & gcm, 1050#-
DST 3628-60, opn 3/4 hrs., rec. 12' vso & gcm, 0#
DST 3666-3703, opn 3/4 hrs., rec. 5' mud 0#
Viola 3811, Simp 3865
DST 3818-67, opn 40 mins., rec. 12' mud, 125#
Arb 3921
TD 3946
D&A

ABANDONED

County Stafford State Kansas

Sec. 6 (Blk. Twp.) 23 (Sur. Rge.) 13W Map No.

Operator Petroleum Inc.

Well No. 1 Farm Miller

Elev. 1925 Location NW SE SW

990 Ft. From S Line SW
 990 Ft. From E Line Quarter

Ist. Report
 Completion MAR 4 1953
 Remarks Wildcat
Garvey - Contr.

Drig. Data D & A TD 3946

8" @ 254 Anhy 813 Heeb. 3342
 Br. lime 3471 Lans. 3489 DST 3517-70
 open 1 hr. Rec. 60' o & gcm 30' o &
 gcm 60' so & gcm 1050# DST 3628-60
 open 3/4 hr. Rec. 12' vso & gcm 0#
 DST 3666-3703 open 3/4 hr. Rec. 5' mud
 0# Viola 3811 Simp. 3865 DST 3818-
 67 open 40 min. Rec. 12' mud 125#
 Arb. 3921 TD 3946

D & A