


Section 6 Township 23 Range 20W

Well No. #1 Jensen

Company Natural Gas & Oil & Rep. Gas.

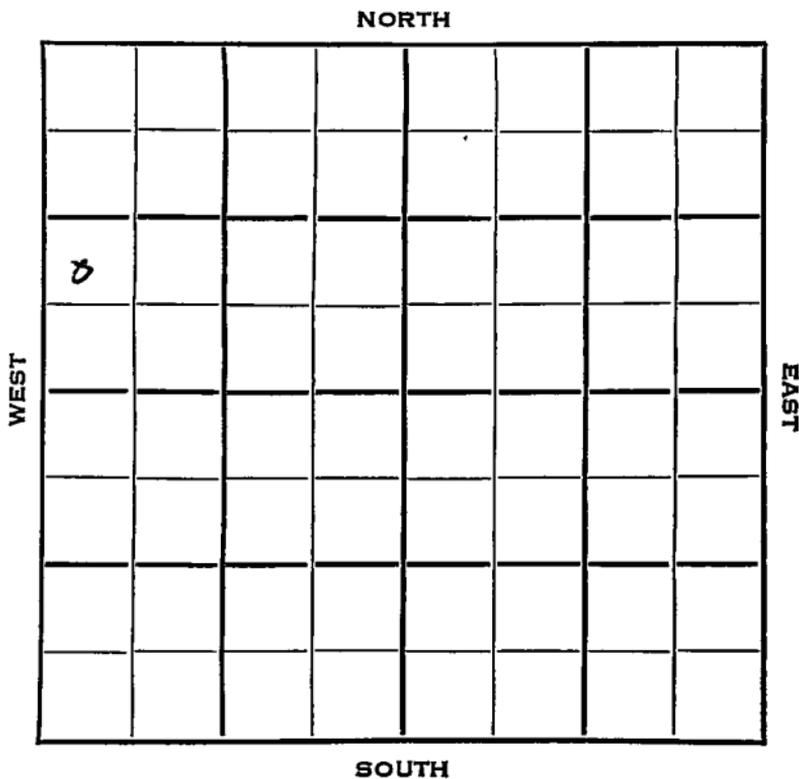


SEC. 6	TWP. 23	R. 20W
-----------	------------	-----------

WELL NO. #1 Hensen FARM
COMPANY

CONTRACTOR Natural Gas & Oil & Rep. Gas.

Co. Tools.
Wildcat.
_____ Ft. from N. Line
990 _____ Ft. from S. Line
_____ Ft. from E. Line
330 _____ Ft. from W. Line

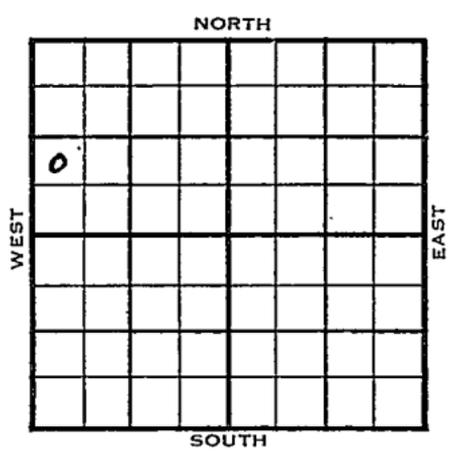

NW SW NW

	ELEVATION	REPORT
1954	2308'	
3/24	Spud 3-19-54 10" @ 211' Anhy 1408', Drlg 2310'	
3/31	Heeb 3858', Br. L.3951', Lans 3961' Drlg 4125'	
4/7	Miss 4497' Ø 4498'-4518' 20' Kh 4594' DST 4581'-4621' 1 hr, 120' SW, 1350# Drlg 4676'	
4/14	Spud 3-19-54 D&A TD 4876 10" @ 211' Anhy 1408', Heeb 3858', Br line 3951', Lans 3961', Miss 4497', Kh 4594' DST 4581-4621', opn 1 hr., rec. 120' sw, 1350# Simp. 4821', Arb. 4836' DST 3848-76', opn 1 hr., rec.125' muddy sw, 1420# TD 4876' D&A	

ABANDONED

County Edwards State KANSAS
 Sec. 6 (Blk.) 23 (Sur.) 20W Map No. (Twp.)
 Operator Natural Gas & Oil & Rep. Gas
 Well No. 1 Farm Jensen
 Elev. 2308 Location NW SW NW

990 Ft. From S Line NW
 330 Ft. From W Line Quarter

Ist. Report

Completion APR 14 1954

Remarks Wildcat

Co. tools

Spudding Date 3-19-54

Drlg. Data D & A TD 4876

10" @ 211 Anhy 1408 Heeb. 3858

Br. lime 3951 Lans. 3961 Miss. 4497

Kh. 4594 DST 4581-4621 open 1 hr.

Rec. 120' sw 1350# Simp. 4821

Arb. 4836 DST 3848-76 open 1 hr.

Rec. 125' muddy sw .. 1420# TD 4876

D & A

J. G. McGEHEE