


Section 6 Township 23 Range 31 W

Well No. # 1 Trekel

Company M & L Oil

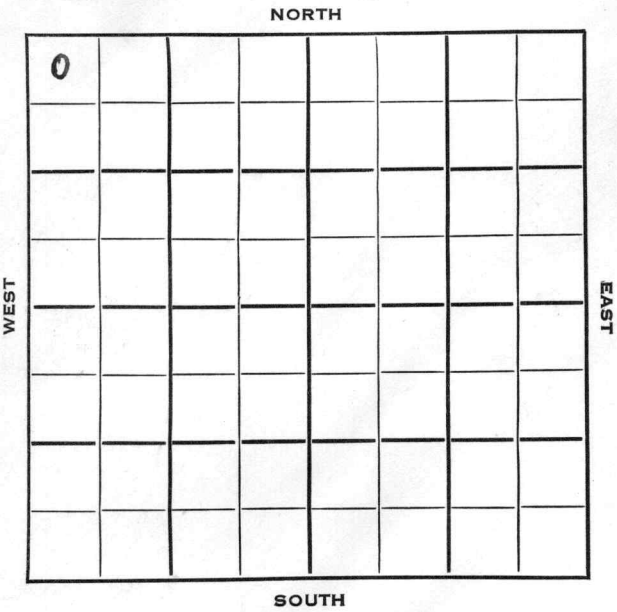

Sec. 6 Twp. 23 R. 31WWell No. #1 Trekel FarmM & L Oil

Company

H & H Drlg.

Contractor

Wildcat330

Ft. from N. Line

Ft. from S. Line

Ft. from E. Line

330


Ft. from W. Line

NW NW NW

Carter acreage & DHM

Conoco & Texas - DHM

1953 Elev. 2919' REPORT

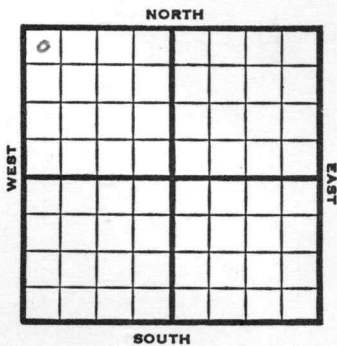

8/26 Spud 8-25-53

9/2 8" @ 348' w/250 sks

Blaine 1490, Anhy 2045, B. Stonecorial
2120', Well 2445, Hol 2668, Her 2695,
Kr. 2720DST 2674-2731 $\frac{1}{2}$ hr, 28' M, 380#

Win 2750, Ft. Riley 2822

DST 2753-2900 failed.

DST 2758-2900' 1 hr, 150' WCM, 445#
15".

Drlg 2915'

9/9 F Flint 2930' Top 3689'

DST 3715-85, 1 hr, 180' WCM 800#

Drlg. 3850'

9/16 Heeb 3983, Tor 3996, Doug 4023, Lans
4028,DST 4300-4327' $\frac{3}{4}$ hr, 1100' Sulph Wtr
1275# 15". Marm 4396'

Drlg 4540'

9/23 D & A

9/30 Spud 8-25-53

D & A

TD 5020'

8" @ 348'

Blaine 1490, Anhy 2045, B. Stone

OVER

1953

Information brought forward.

9/30 Corral 2120, Wellington 2445, Hol.
2668, Her. 2695, Kri 2720,
DST 2674-2731' opn $1\frac{1}{2}$ hr, rec 28' mud
380 #
Win 2750, Ft. Riley 2822,
DST 2753-2900' failed.
DST 2758-2900' opn 1 hr, rec 150' wcm
445# Florence Flint 2930, Top 3689,
DST 3715-85' opn 1 hr, rec 180' wcm
800# Heeb 3983, Tor 3996, Doug 4023,
Lans 4028
DST 4300-27' opn $3\frac{1}{4}$ hr, rec 1100'
sul. wtr. 1275# Marm 4396, Cherokee
4670, Cong 4785
DST 4723-4814 opn $1\frac{1}{4}$ hr, rec 1260' sw
1245# Miss 4816, St. Louis 4926,
TD 5020'
D & A

ABANDONED

County Finney State KansasSec. 6 (Blk. Twp.) 23 (Sur. Rge.) 31W Map No.Operator M & L OilWell No. 1 Farm TrekelElev. Location NW NW NW

0									

330 Ft. From N Line NW330 Ft. From W Line Quarter1st. Report AUG 26 1953Completion Carter acreage & DEIMRemarks Conoco & Texas - DEIMH & H Drlg. - Contr.Spudding Date 8-25-53Drlg. Data Wildcat

County Finney State KansasSec. 6 (Blk.) 23 (Sur.) 31W Map No.Operator M & L OilWell No. 1 Farm TrekelElev. 2919 Location NW NW NW

0							

330 Ft. From N Line NW330 Ft. From W Line Quarter

1st. Report

Completion SEP 30 1953Remarks WildcatH & H Drlg. - Contr.Spudding Date 8-25-53Drlg. Data D & A TD 50208" @ 348 Blaine 1490 Anhy 2045B. Stone Corral 2120 Wellington 2445Hol. 2668 Her. 2695 Kri. 2720DST 2674-2731 open 1½ hr. Rec. 28' mud380# Win. 2750 Ft. Riley 2822DST 2753-2900 failed DST 2758-2900open 1 hr. Rec. 150' wcm 445#Florence flint 2930 Top. 3689DST 3715-85 open 1 hr. Rec. 180' wcm800# Heeb. 3983 Tor. 3996 Doug. 4023Lans. 4028 DST 4300-27 open 3/4 hr.Rec. 1100' sul. wtr. 1275# Marm. 4396Cherokee 4670 Cong. 4785 DST 4723-4814open 1¼ hr. Rec. 1260' sw 1245#

J. G. McGEHEE

Drlg. Data

Miss. 4816 St. Louis 4926 TD 5020

D & A Inc.

100

~~4531~~

SECRET

11/8/44

1744

cards

Scott

1953

8 OCT