


Section 6 Township 23 Range 32 W

Well No. #1 George Gano Unit

Company Texas Co.

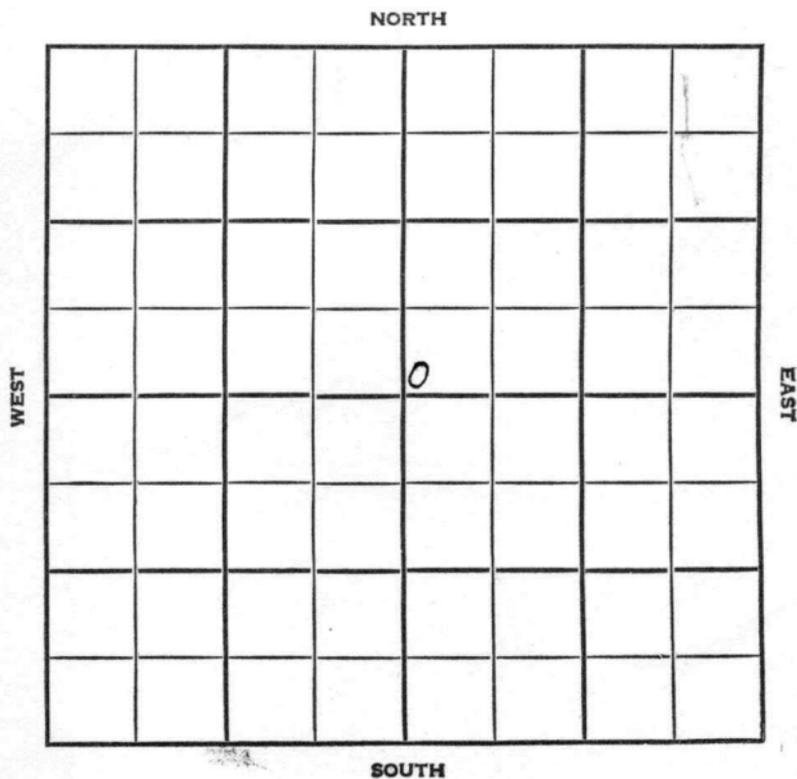


SEC. 6	TWP. 23	R. 32W
-----------	------------	-----------

WELL NO. #1 George Gano Unit FARM

COMPANY Texas Co.

CONTRACTOR Walter Kuhn  
Hugoton

\_\_\_\_\_ Ft. from N. Line  
75' \_\_\_\_\_ Ft. from S. Line  
\_\_\_\_\_ Ft. from E. Line  
75' \_\_\_\_\_ Ft. from W. Line

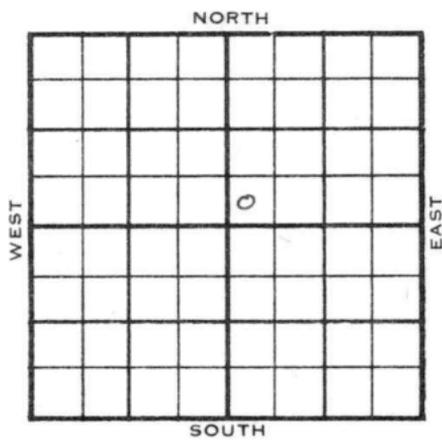

SW SW NE

1955	ELEVATION 2852'	REPORT
------	--------------------	--------

8/17 M I R

9/7 Comm 8-17-55  
 10 3/4" @ 545 w/350  
 7" @ 2669 w/900  
 H Holl 2511  
 Tr Herr 2534  
 Dg Kri 2554  
 Bl Winf 2595  
 Ft. Riley 2666  
 TD 2670  
 CO to 2637 60/2555-70 1000 A  
 223 mcfg 10 gwph 327 mcfg 3 gwph  
 10 hr frac perf 2511-19 1000 A  
 6,530 mcfg 37 gaw 1 hr  
 Comp 7,920 mcfgpd 425#

COMPLETED

County Finney Elev. \_\_\_\_\_  
 Sec. 6 Twp. 23 Rge. 32W  
 Company Texas Company  
 Farm Name George Gano Unit No. 1

TOPS	DEPTH	LOG	DATUM
Anh.			
Tp.			
H.			
Tr.			
Dg.			
Bl.			
L.			
K.C.			
B.K.C.			
Ce.			
C.			
M.			
M.			
K.			
Mz.			
Me.			
V.			
S.			
S.			
A.			
R.			
PE.			
G.			
T.D.			

Loc. in Sec. \_\_\_\_\_  
SW SW NE  
75' SL  
75' WL

Geol. \_\_\_\_\_  
 Contr. \_\_\_\_\_  
Walter Kuhn

Pool \_\_\_\_\_  
Hugoton

AVG 17 '55	
	0
FIRST REPORT	

Date Comm. MIR

*[Faint stamp and handwritten signature]*

Co.  
Lse.  
No.  
Sec.  
T.  
R.

County Finney Elev. 2852  
 Sec. 6 Twp. 23 Rgs. 32W  
 Company Texas Company  
 Farm Name George Gano Unit No. 1

TOPS	DEPTH	LOG	DATUM
Anh.			
Tr.			
H. <u>Halk</u>	<u>2511</u>		
Tr. <u>Hears</u>	<u>2534</u>		
Dg. <u>Kip</u>	<u>2554</u>		
Bl. <u>Wind</u>	<u>2575</u>		
L. <u>FF Kelley</u>	<u>2666</u>		
K.C.			
B.K.C.			
Ce.			
C.			
M.			
M.			
K.			
Mz.			
Mq.			
V.			
S.			
S.			
A.			
R.			
PE.			
G.			
T.D.	<u>2670</u>		

Loc. in Sec. SW SW NE  
75' SL  
75' WL  
 Geol. \_\_\_\_\_  
 Contr. Walter Kuhn  
 Pool Hugoton

COMPLETE

Date Comm. 8-17-55 SEP 7 1955

10 3/4" @ 545/350 7" @ 2669/900  
CO to 2637 60/ 2555-70 1000 A

223 mcfg 10 gwph 327 mcfg 3 gwph 10  
frac perf. 2511-19 1000 A 6,530 mcfg  
37 gaw 1 hr. Comp. 7,920 mcfgpd 425#

Co. Use. No. Sec. T. R.