


Section 6 Township 23 Range 35W

Well No. 1 Branine

Company Stanolind Oil and Gas Company

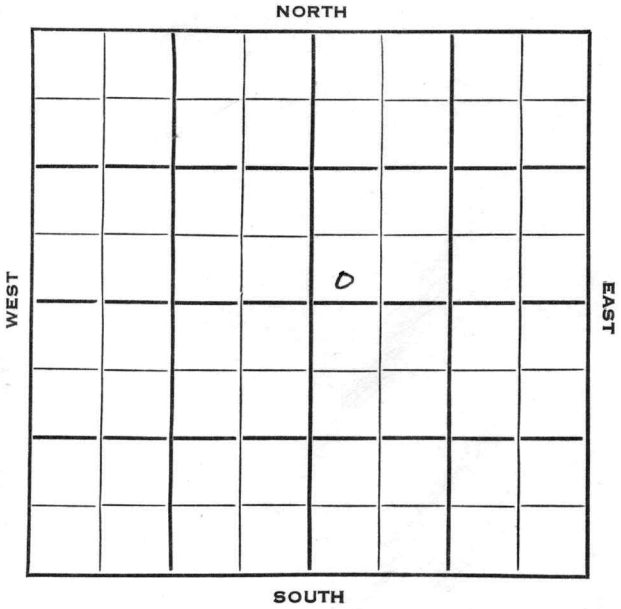

Sec. 6 Twp. 23 R. 35W

Well No. #1 Branine Farm _____

Stanolind Company _____


Contractor _____

_____ Ft. from N. Line

150 Ft. from S. Line

_____ Ft. from E. Line

150 Ft. from W. Line

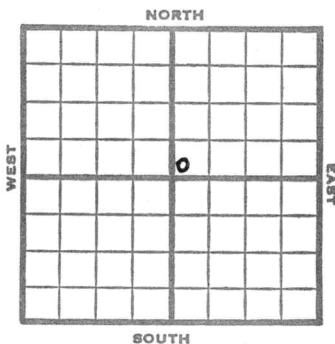

SW NE

1953 Elev. 3134' REPORT

1/14 Location

1/22 "

1/29 "

2/5 "

2/12 "

2/20 "

2/26 Location

3/12 8" @ 830 w/475
Her 2585, Win 2651,
Schl RTD 2655
5" @ 2651

3/19 TD 2665'
Dol-frac

3/26 PB 2640' 36/2585-91 54/2593-2602
24/2612-16 30/2619-24 Dol-frac.
4000

4/1 Spud 2-27-53 Gas well TD 2665'
8" @ 830 Her. 2585' Win. 2651'
TD 2655 DD 2665 5" @ 2651
dol-frac. PB 2640 36/2585-91
54/2593-2602 24/2612-16 30/2619-24
dol-frac. 4000 A
Comp. 9,121,000 gas 310#

COMPLETED

