DX 78-1

Kearny KANSAS

Section 6 Township 23 Range 37W

Well No. #1 Weber "B"

Company Graham-Michaelis

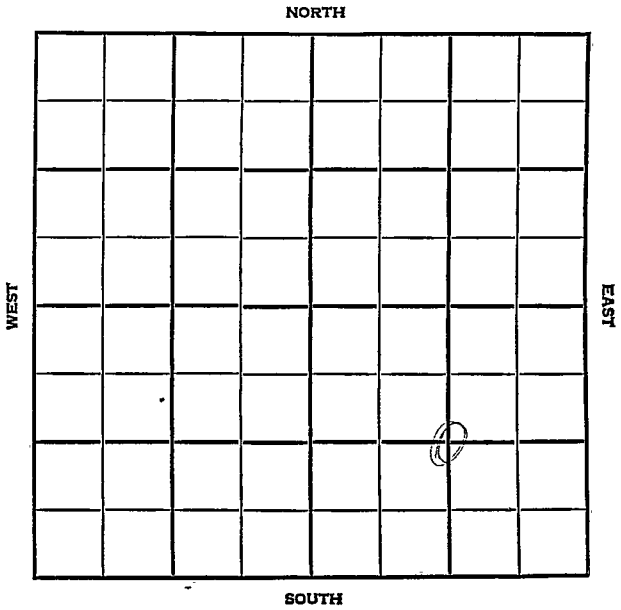

FORM 513 SUNRAY

County Kearny Elev. Co.

Sec. 6 Twp. 23 Rge. 37W

Company Graham-Michalis

Farm Name Weber "B" No. 1

TOPS	DEPTH	LOG	DATUM
Anh.			
Tp.			
H.			
Tr.			
Dg.			
Bl.			
L.			
K.C.			
B.K.C.			
Ce.			
C.			
M.			
M.			
K.			
Mz.			
Mo.			
V.			
S.			
S.			
A			
R.			
Pe.			
G.			
T.D.			

Loc. in Sec. C SE

Geol.

Contr.

Lse.

Pool

FIRST REPORT
OCT 24 '56

No.

Date Comm. Spd. 10-19-56

8" @ 306 w/200, Drlg. 2161

Sec.

T.

R.

FORM 513 SUNRAY

County Kearny Elev. 3309

Sec. 6 Twp. 23 Rge. 37W

Company Graham-Michalis

Farm Name Weber "B" No. 1

TOPS	DEPTH	LOG	DATUM
Anh.			
Tp. Holl	2537		
H. Herr Kri	2571		
Tr.			
Dg.			
Bl.			
L.			
K.C.			
B.K.C.			
Ce.			
C.			
M.			
M.			
K.			
Mz.			
Mo.			
V.			
S.			
S.			
A			
R.			
Pe.			
G.			
TD	2575		

Loc. in Sec. C SE

Geol.

Contr.

Pool

COMPLETE

NOV 1 '56

Date Comm. spd. 10-19-56

8" @ 306 w/200, Drlg. 2161 OCT 31 '56

5½ @ 2571/300 NOV 1 '56 DD 2615

ga 231 MCF A ga 531 MCF

DD 2647 Frac ga 1,300 MCF

72-20 3,784 MCF RP 413#

Co. Lse. No. Sec. T. R.