

Section 7 Township 23 Range 3-W

Well No. 2 Bott

Company Drillers Gas

Burrtton Pool

NORTH

WEST

EAST

SOUTH

					1		
					1		

13

Sec. 7 Twp. 23 R. 3-W

Well No. #2 Bott Farm _____

Drillers Gas Company _____

Burrton Pool


_____ Ft. from N. Line

660 Ft. from S. Line

_____ Ft. from E. Line

330 Ft. from W. Line

G W L SW SW

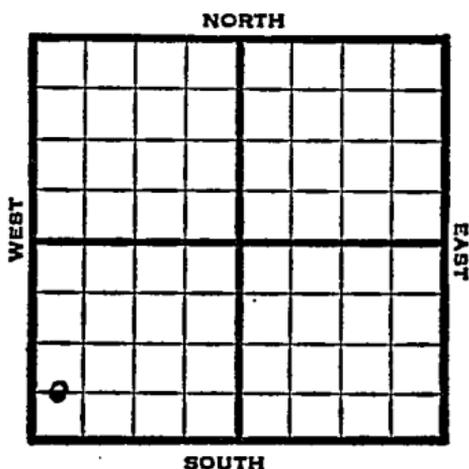

1947 El 1482' REPORT

7/9 Mississippi 3396'
Drlg 3397'

7/15 "

7/22 5" @ 3317'
TD 3377'

7/29 "

8/6 Miss 3295'
5" @ 3317'
1000 Acid.
Pump 30 Pot.
Gr. 36
T.D. 3377'
Complete

COMPLETED

Map No. _____ Sec. 7 Twp. 23 R. 3W

Well No. 2 Bott

Drillers Gas Company

FIRST REPORT

Contractor

C W L SW SW

SECTION PLAT

_____ Ft. from N. Line

660 Ft. from S. Line

_____ Ft. from E. Line

330 Ft. from W. Line

Harvey County

Location _____

Rig up _____

Drilling and Remarks:

Miss. 3396
drlg. 3397

RECORD

Cased _____ in., _____ ft.

Sand _____

Gas _____

Oil _____

Total Depth _____

PRODUCTION

1st 24 hrs. Nat. _____

1st 24 hrs. after shot _____

Gas _____ Cu. Ft.

Dry Hole _____

Abandoned _____

Date

JUL 9 1947

19

S. J. LEWIS

Scout

Kansas Burrton Pool

Map No. 39 Sec. 7 Twp. 23 R. 3W

Well No. 2 Bott

Drillers Gas _____ Company _____

COMPLETE

Contractor

C W L SW SW

E 11482
SECTION PLAT

_____ Ft. from N. Line

660 Ft. from S. Line

_____ Ft. from E. Line

330 Ft. from W. Line

0			

Harvey County

Location _____

Rig up _____

Drilling and Remarks: ^u

Misc 8295
5" 10317
1000 Gallons
Pump 30 Rd

36 2/3

RECORD

Cased _____ in., _____ ft.

Sand _____

Gas _____

Oil _____

Total Depth 2977

PRODUCTION

1st 24 hrs. Nat. _____

1st 24 hrs. after shot _____

Gas _____ Cu. Ft.

Dry Hole _____

Abandoned _____

Date

AUG 6 1947 19

S. J. LEWIS

Scout