


Section 7 Township 23 Range 3W

Well No. 2 Bott

Company Drillers Gas

Burrton Pool
NORTH

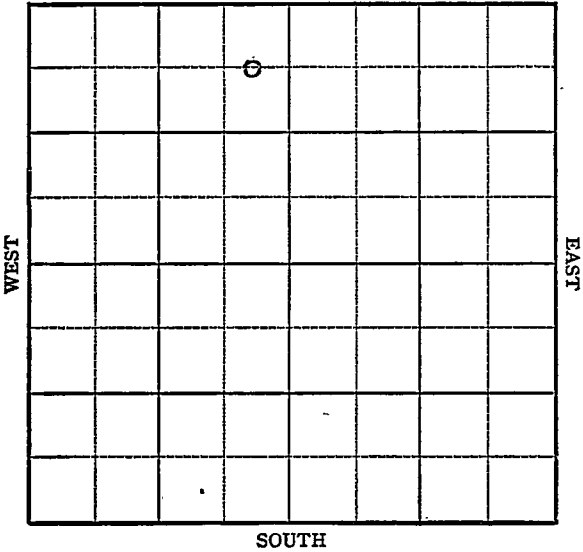

Harvey

KANSAS

Sec. 7 Twp. 23 R. 3W

Well No. #2 Bott Farm

Driller Gas

Company

Burrton Pool


660' Ft. from N. Line

 Ft. from S. Line

330' Ft. from E. Line

 Ft. from W. Line

C E L NE NW

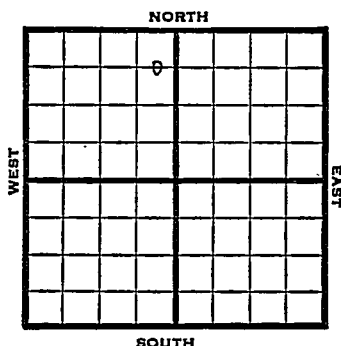

1949

Elev. 1490' REPORT

1/12

Location

1/19

Drlg 1215'

1/26

8" @ 283'

Drlg 2926'

2/2

Drlg 2950'

2/9

Miss 3279'

TD 3353'

4" @ 3348'

2/16

Miss 3279'

4" @ 3348'

4000 acid

Pump 40 oil Pot.

Gr. 38°

TD 3377'

COMPLETED

~~Kauons~~Map No. _____ Sec. 7 Twp. 23 R. 3WWell No. 2 Bott

Drillers Gas _____

Company _____

FIRST REPORT

Contractor _____

C E L NE NW

SECTION PLAT

660 Ft. from N. Line

_____ Ft. from S. Line

330 Ft. from E. Line

_____ Ft. from W. Line

Harvey County

RECORD

Location X

Cased _____ in., _____ ft.

Rig up _____

Sand _____

Drilling and Remarks:

Gas _____

Oil _____

Total Depth _____

PRODUCTION

1st 24 hrs. Nat. _____

1st 24 hrs. after shot _____

Gas _____ Cu. Ft.

Dry Hole _____

Abandoned _____

Date

JAN 1 2 1949

19

S. J. LEWIS

Scout

Map No. K39 Sec. 7 Twp. 23 R. 3W

Well No. 2 Bott

Drillers Gas _____ Company

COMPLETE _____ Contractor

C E L NE NW

E11490
SECTION PLAT

660 Ft. from N. Line

_____ Ft. from S. Line

330 Ft. from E. Line

_____ Ft. from W. Line

	0		

Harvey County

Location _____

Rig up _____

Drilling and Remarks:

Miss 3277
4" @ 3345'
4000 acal
Pump 40 oil Box
352/2

RECORD

Cased _____ in., _____ ft.

Sand _____

Gas _____

Oil _____

Total Depth 3277

PRODUCTION

1st 24 hrs. Nat. _____

1st 24 hrs. after shot _____

Gas _____ Cu. Ft.

Dry Hole _____

Abandoned _____

Date

FEB 16 1949 19 _____ S. J. LEWIS _____ Scout