

KANSAS

Harvey


Section 7 Township 23 Range 3WWell No. 3 E. Botts "A"Company Drillers Gas

Burton

NORTH

WEST

EAST

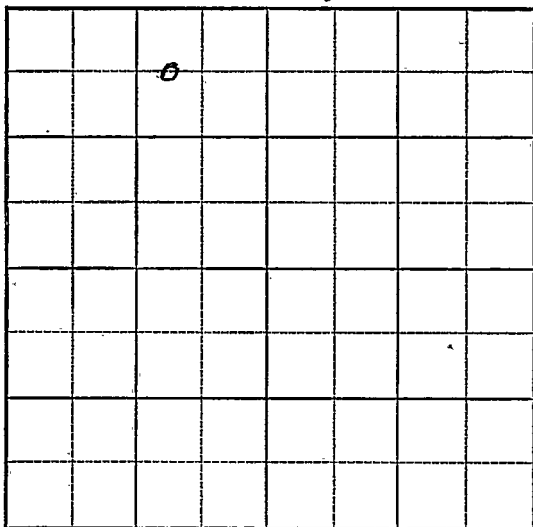

SOUTH

KANSAS

Harvey



Sec. 7 Twp. 23 R. 3W

Well No. #3 E. Botts "A" Farm

Driller Gas

Company

Burrton Pool (Spink, Cont.)

NORTH


660' Ft. from N. Line

 Ft. from S. Line

990' Ft. from E. Line

 Ft. from W. Line

C W L NE NW

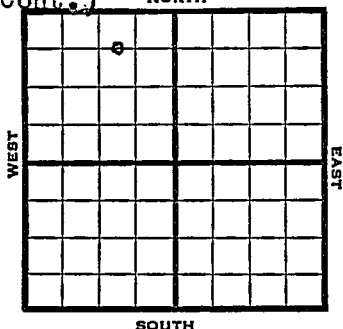

1949

Elev. 1495' REPORT

5/25

8" @ 305'
Drlg. 801'

6/1

Miss 3286
TD 3360
4" @ 3357'

6/7

TD 3376' SSO

6/15

TD 3388'
4000 acid
Pump 3 bbls oil PH

6/22

Miss 3286'
4" @ 3357'
Pump 30 oil Pot.
Gr. 36°
TD 3388'

COMPLETED

Kansas

Map No. _____ Sec. 7 Twp. 23 R. 3WWell No. 3 E. Botts "A"

Drillers Gas _____ Company

Spink _____ Contractor

C W L NE NW

FIRST REPORT
SECTION PLAT660 Ft. from N. Line

_____ Ft. from S. Line

990 Ft. from E. Line

_____ Ft. from W. Line

	o		

Harvey County

Location _____

Rig up _____

Drilling and Remarks:

8" @ 305

drlg. 800

RECORD

Cased _____ in., _____ ft.

Sand _____

Gas _____

Oil _____

Total Depth _____

PRODUCTION

1st 24 hrs. Nat. _____

1st 24 hrs. after shot _____

Gas _____ Cu. Ft.

Dry Hole _____

Abandoned _____

Date

MAY 25 1949 19

S. J. LEWIS

Scout

Kansas

Map No. 139 Sec. 7 Twp. 23 R. 3WWell No. 3 E. Botts "A"

Drillers Gas

Company

COMPLETE

Contractor

C W L NE NW

E11495

SECTION PLAT

660 Ft. from N. Line

Ft. from S. Line

990 Ft. from E. Line

Ft. from W. Line

	o		

Harvey County

RECORD

Location

Cased _____ in., _____ ft.

Rig up

Sand

Drilling and Remarks:

Gas

Oil

Total Depth 2380

PRODUCTION

1st 24 hrs. Nat.

1st 24 hrs. after shot

Gas _____ Cu. Ft.

Dry Hole

Abandoned

Date

JUN 22 1949

19

S. J. LEWIS

Scout