


Section 7 Township 23 Range 3W

Well No. 5 Bott "B"

Company Drillers Gas

Burton
NORTH

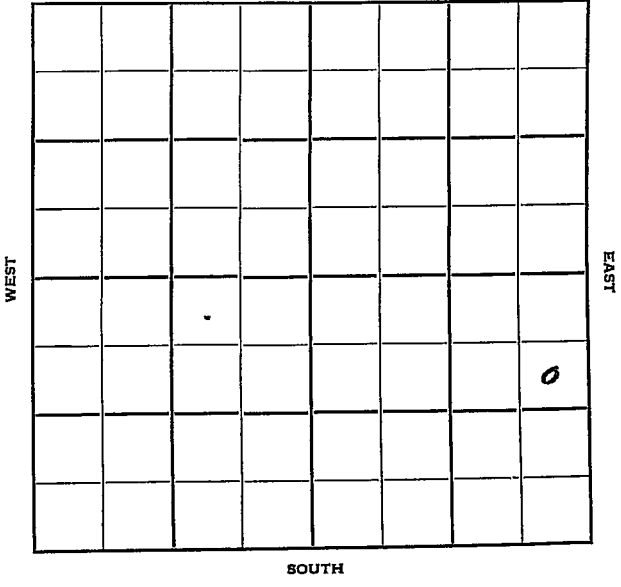

9

0

Sec. 7 Twp. 23 R. 3W

Well No. #5 Bott "B" Farm _____

Drillers Gas Company _____


Burrton Pool

990' Ft. from N. Line

_____ Ft. from S. Line

330' Ft. from E. Line

_____ Ft. from W. Line

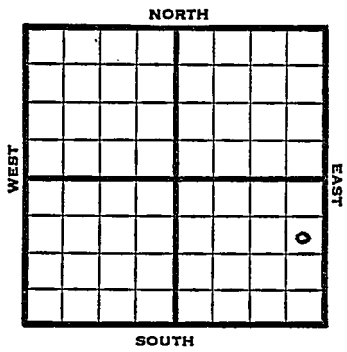

SE NE SE

1949 Elev 1475' REPORT

- 8/31 Location
- 9/7 8" @ 285'
- Drilg. 1458'
- 9/14 M₂ss 3278
- TD 3360'
- 9/21 TD 3377' wtr.
- 9/28 "
- 10/5 2000 acid
- 10/12 "
- 10/19 TD 3377'
- Miss 3278'
- 5" @ 3352'
- Perf
- 4000 acid
- Pump 30 Oil Pot
- 37 Gr.
- Comp

COMPLETED

Map No. _____ Sec. 7 Twp. 23 R. 3W

Well No. 5 Bott "B"

Drillers Gas _____ Company _____

Contractor _____

SE NE SE

FIRST REPORT
SECTION PLAT

990 Ft. from N. Line

_____ Ft. from S. Line

330 Ft. from E. Line

_____ Ft. from W. Line

			△

Harvey County

Location X

Rig up _____

Drilling and Remarks:

RECORD

Cased _____ in., _____ ft.

Sand _____

Gas _____

Oil _____

Total Depth _____

PRODUCTION

1st 24 hrs. Nat. _____

1st 24 hrs. after shot _____

Gas _____ Cu. Ft.

Dry Hole _____

Abandoned _____

Date

AUG 31 1949 19

S. J. LEWIS Scout

Map No. _____ Sec. 7 Twp. 23 R. 3W

Well No. 5 Botts "B"

_____ Drillers Gas _____ Company

COMPLETE

Contractor

E. L. 1475

SE NE SE

SECTION PLAT

990 Ft. from N. Line

_____ Ft. from S. Line

330 Ft. from E. Line

_____ Ft. from W. Line

			o

Harvey County

RECORD

Location _____

Cased _____ in., _____ ft.

Rig up _____

Sand _____

Drilling and Remarks:

Gas _____

Alu's 3278.

Oil _____

S. C. 3352

Total Depth 3277

Perf.

PRODUCTION

Hoocast

1st 24 hrs. Nat. _____

1st 24 hrs. after shot _____

Only 30 oil prod

Gas _____ Cu. Ft. _____

Dry Hole _____

Abandoned _____

Date

OCT 19 1949 19

S. J. LEWIS Scout