

KANSAS

Harvey


Section 7 Township 23 Range 3W

Well No. 1 Bott "D"

Company Drillers Gas

Burston

NORTH

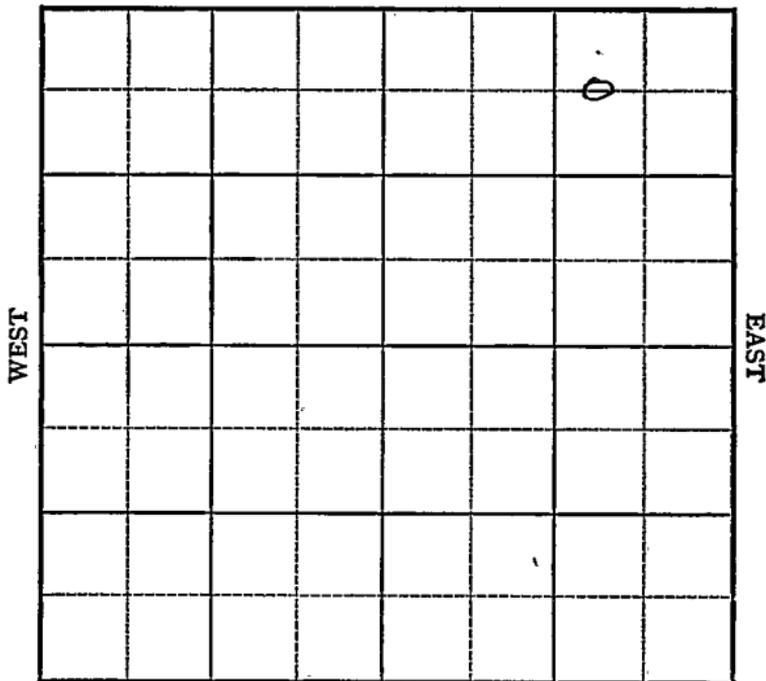

SOUTH

KANSAS

Harvey

Sec. 7 Twp. 23 R. 3W ✓

Well No. #1 Bott "D" Farm

Drillers Gas Company


Burrton Pool

660' Ft. from N. Line

_____ Ft. from S. Line

990' Ft. from E. Line

_____ Ft. from W. Line

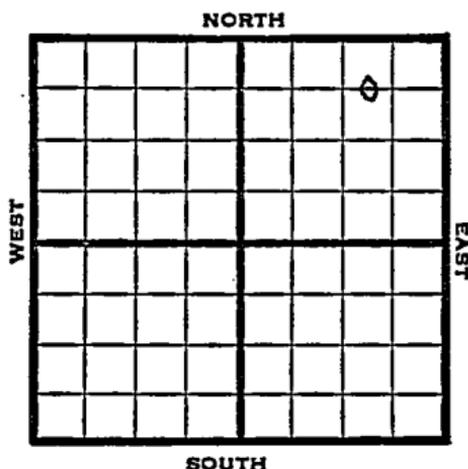

C W L NE NE

1949

Elev 1491' REPORT

6/1 RUR
 6/7 12"@ 300'
 Drlg 1293'
 6/15 Lansing 2917'
 Drlg. 3046'
 6/21 Miss 3275'
 TD 3365'
 7" @ 3363'
 6/28 "
 7/6 7" Leading 4" @ 3364'
 7/13 TD 3383'
 Miss 3275'
 7"@ 3363'
 4"@ 3362'
 4000 acid
 Pump 30 Oil / 25 W Pot
 36° Gr.
 Comp

COMPLETED

Map No. _____ Sec. 7 Twp. 23 R. 3W

Well No. 1 Bott "D"

Drillers Gas Company

Contractor

C W L NE NE

FIRST REPORT
SECTION PLAT

660 Ft. from N. Line

_____ Ft. from S. Line

990 Ft. from E. Line

_____ Ft. from W. Line

			<i>p</i>

Harvey County

Location _____

Rig up _____

Drilling and Remarks:

R U R

RECORD

Cased _____ in., _____ ft.

Sand _____

Gas _____

Oil _____

Total Depth _____

PRODUCTION

1st 24 hrs. Nat. _____

1st 24 hrs. after shot _____

Gas _____ Cu. Ft.

Dry Hole _____

Abandoned _____

Date

JUN 1 1949

19

S. J. LEWIS

Scout

