

# KANSAS


Harvey County

Section 7 Township 23 Range 3-W

Well No. #2 Bott "D"

Company Drillers Gas  
Burrton Pool

NORTH

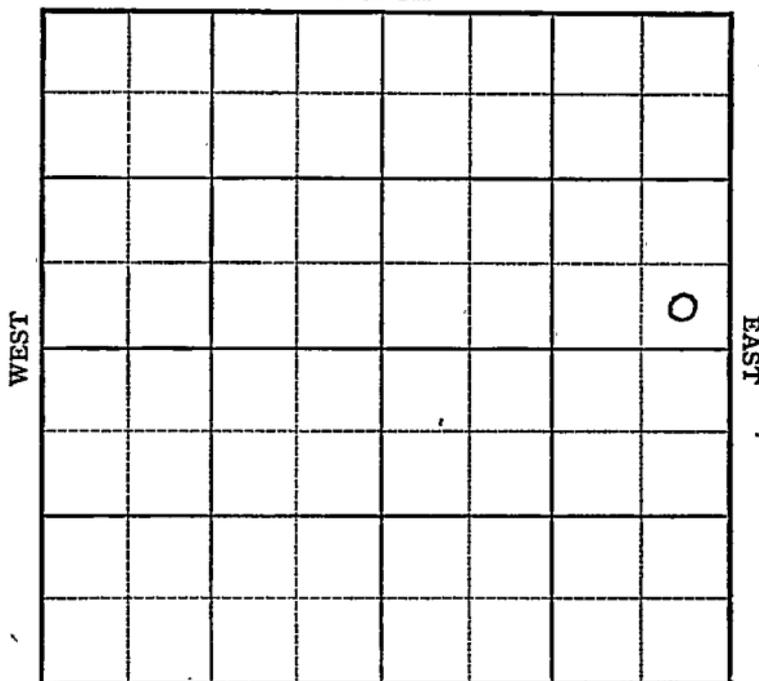

SOUTH

8

KANSAS

Harvey ✓

Sec. 7 Twp. 23 R. 3W

Well No. 2 Bott "D" Farm \_\_\_\_\_


Drillers Gas \_\_\_\_\_

Company \_\_\_\_\_

Burrton Pool

Contr -

NORTH

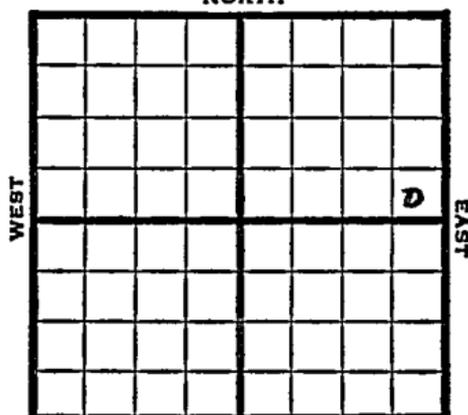

\_\_\_\_\_ Ft. from N. Line

330 Ft. from S. Line

330 Ft. from E. Line

\_\_\_\_\_ Ft. from W. Line

SE NE

SOUTH

1949

Elev 1483'

REPORT

8/24

8" @ 297

Anhy 480

Drlg 500

8/31

Lansing 2797'

Drlg 3000'

9/7

Miss 3286'

TD 3365'

5" @ 3354'

9/14

TD 3382'

Miss 3286'

5" @ 3354'

4000 acid

Pump 50 oil / 35 W Pot

36° Gr.

Comp

**COMPLETED**

Map No. \_\_\_\_\_ Sec. 7 Twp. 23 R. 3W

Well No. 2 Bott "D"

Drillers Gas \_\_\_\_\_ Company \_\_\_\_\_

Contractor \_\_\_\_\_

SE NE

FIRST REPORT  
SECTION PLAT

\_\_\_\_\_ Ft. from N. Line

330 Ft. from S. Line

330 Ft. from E. Line

\_\_\_\_\_ Ft. from W. Line


Harvey County

Location \_\_\_\_\_

Rig up \_\_\_\_\_

Drilling and Remarks:

8" @ 297

Anhy 480

drlg. 500

RECORD

Cased \_\_\_\_\_ in., \_\_\_\_\_ ft.

Sand \_\_\_\_\_

Gas \_\_\_\_\_

Oil \_\_\_\_\_

Total Depth \_\_\_\_\_

PRODUCTION

1st 24 hrs. Nat. \_\_\_\_\_

1st 24 hrs. after shot \_\_\_\_\_

Gas \_\_\_\_\_ Cu. Ft.

Dry Hole \_\_\_\_\_

Abandoned \_\_\_\_\_

Date

AUG 24 1949 19

S. J. LEWIS Scout

Kansas

Map No. K39 Sec. 7 Twp. 23 R. 3W

Well No. 2 Bott "D"

Drillers Gas \_\_\_\_\_ Company

**COMPLETE**

Contractor

SE NE

*E. 1143*  
SECTION PLAT

\_\_\_\_\_ Ft. from N. Line

330 Ft. from S. Line

330 Ft. from E. Line

\_\_\_\_\_ Ft. from W. Line

			8

Harvey County

Location \_\_\_\_\_

Rig up \_\_\_\_\_

Drilling and Remarks:

*Miss 3286.  
5' Cas 354  
4000 casing  
Pony Soil +  
35W 027*

*36 2/2*

**RECORD**

Cased \_\_\_\_\_ in., \_\_\_\_\_ ft.

Sand \_\_\_\_\_

Gas \_\_\_\_\_

Oil \_\_\_\_\_

Total Depth 3302

**PRODUCTION**

1st 24 hrs. Nat. \_\_\_\_\_

1st 24 hrs. after shot \_\_\_\_\_

Gas \_\_\_\_\_ Cu. Ft.

Dry Hole \_\_\_\_\_

Abandoned \_\_\_\_\_

Date

SEP 1 4 1949

19

S. J. LEWIS

Scout