


KANSAS

Harvey

Section 7 Township 23S Range 3W

Well No. #3 Botts "D"

Company Drillers Gas

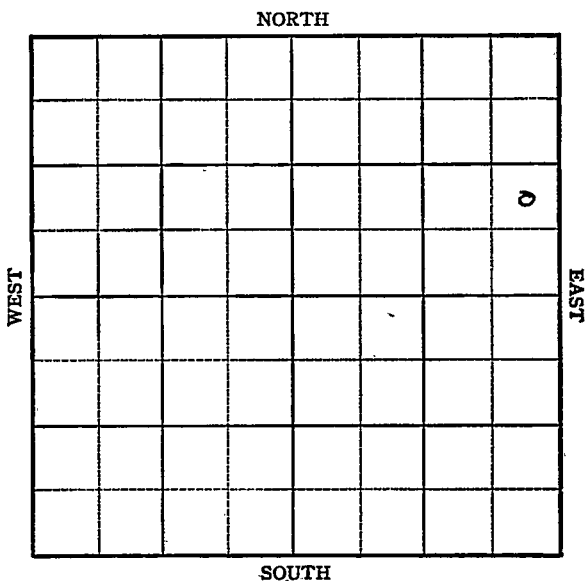

Sec. 7 Twp. 23 R. 3W

Well No. #3 Botts "D" Farm

Drillers Gas

Burrton Pool (Springer, Cont.) Company

_____ Ft. from N. Line

990'


_____ Ft. from S. Line

330'

_____ Ft. from E. Line

_____ Ft. from W. Line

NE SE NE

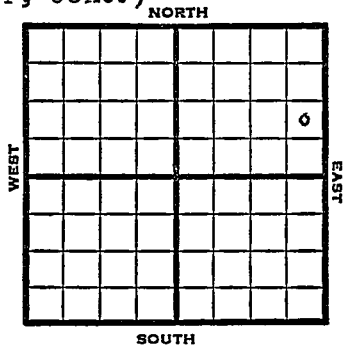

1949 Elev. 1487' REPORT

9/14 RUR
 9/21 8" @ 310'
 Drlg. 2180'
 9/28 Miss 3280'
 TD 3365'
 5" @ 3365'
 10/5 "
 10/12 TD 3379'
 4000 acid
 10/19 " "
 10/26 Miss 3280'
 5" @ 3365'
 Acid 4000
 Pump 25 oil Pot.
 Gr. 36°
 TD 3379'

COMPLETED

Kansas

Map No. _____ Sec. 7 Twp. 23 R. 3WWell No. 3 Botts "D"

_____ Drillers Gas _____ Company

_____ Springer _____ Contractor

NE SE NE

SECTION PLAT

_____ Ft. from N. Line

990 Ft. from S. Line330 Ft. from E. Line

_____ Ft. from W. Line

			o

Harvey County

Location _____

Rig up _____

Drilling and Remarks:

R U R

RECORD

Cased _____ in., _____ ft.

Sand _____

Gas _____

Oil _____

Total Depth _____

PRODUCTION

1st 24 hrs. Nat. _____

1st 24 hrs. after shot _____

Gas _____ Cu. Ft.

Dry Hole _____

Abandoned _____

Date

SEP 14 1949

19

S. J. LEWIS

Scout

Kansas

Burrton Pool

Map No. _____ Sec. 7 Twp. 23 R. 3W

Well No. 3 Botts "D"

Drillers Gas _____

Company _____

COMPLETE

Contractor _____

NE SE NE

E. 1487
SECTION FLAT

_____ Ft. from N. Line

990 Ft. from S. Line

330 Ft. from E. Line

_____ Ft. from W. Line

Harvey County

Location _____

Rig up _____

Drilling and Remarks:

W. 1/2 Sec 2280
5' C 2365
4000' acc'd
Only 25' oil
36 1/2'

RECORD

Cased _____ in., _____ ft.

Sand _____

Gas _____

Oil _____

Total Depth *2275*

PRODUCTION

1st 24 hrs. Nat. _____

1st 24 hrs. after shot _____

Gas _____ Cu. Ft.

Dry Hole _____

Abandoned _____

Date

OCT 26 1949

19

S. J. LEWIS

Scout