


Section 7 Township 23 Range 3W

Well No. #4 E. Bott "D"

Company Drillers Gas

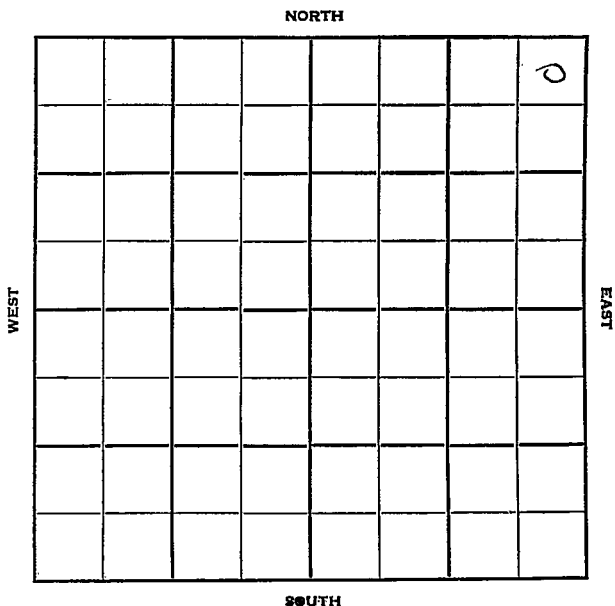

Harvey
23

KANSAS
3W ✓

Sec. 7 Twp. _____ R. _____

Well No. #4 E. Bott "D" Farm _____

Drillers Gas Company _____

Springer - Contr. Contractor _____


330' Burton Pool
Ft. from N. Line

_____ Ft. from S. Line

330' Ft. from E. Line

_____ Ft. from W. Line

NE NE NE

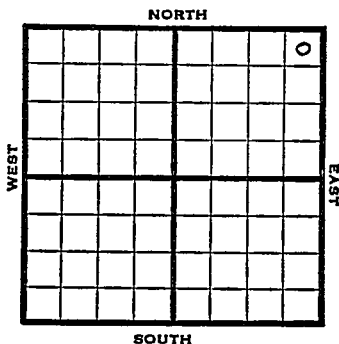

1950

Elev. 1490'

REPORT

11/29 Spud 11-22-50
Drlg.

12/27 Spud 11-22-50
Oil Well TD 3394
KC 2874 Miss 3300-90
5" @ 3383
TD 3394 SO 2000 A
Comp. 25 bo 15 bwpd

COMPLETED

County Harvey State KansasSec. 7 (Blk.
Twp.) 23 (Sur.
Rge.) 3W Map No.Operator Drillers GasWell No. 4 Farm E. Bott "D"Elev. 1490 Location NE NE NE

									0

330 Ft. From N Line NE330 Ft. From E Line Quarter1st. ReportCompletion DEC 27 1950Remarks Burton PoolSpringer - Contr.Spudding Date 11-22-50Drlg. Data Oil well TD 3394KC 2874 Miss. 3300-90 5" @ 3383TD 3394 SO 2000 A Comp. 25 bo 15 bwpd

J. E. TYRA