


Section 7 Township 23 Range 3W

Well No. 2 Botts "B"

Company Drillers Gas

Burrton Pool  
NORTH

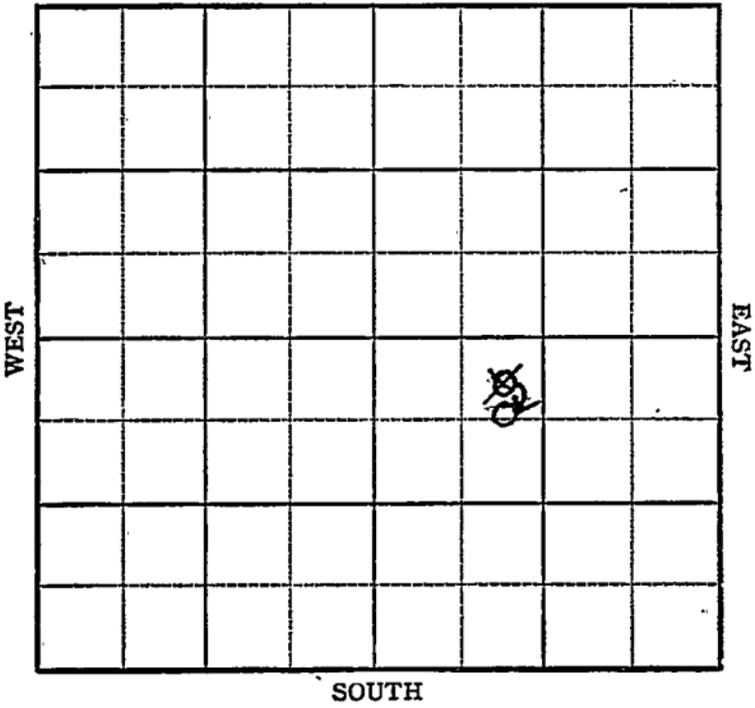

10

Sec. 7 Twp. 23 R. 3-W

Well No. #2 Botts "B" Farm \_\_\_\_\_

Drillers Gas Company \_\_\_\_\_


Burrton Pool

660 Ft. from N. Line

\_\_\_\_\_ Ft. from S. Line

\_\_\_\_\_ Ft. from E. Line

990 Ft. from W. Line

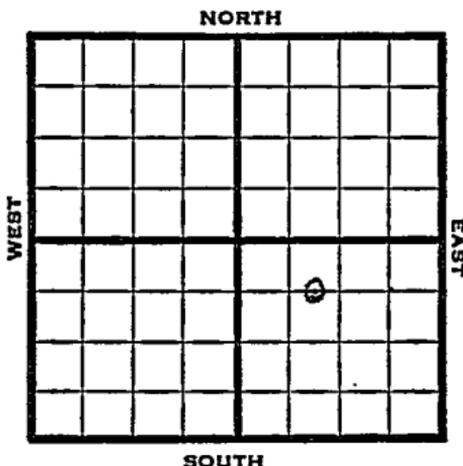

C E L N W S E

REPORT

1948	Eli 1475'
11/3	RUR
11/10	8" @ 284' Drlg 2225'
11/16	Miss 3270' TD 3344' 4" @ 3343'
11/23	"
12/1	TD 3373' Miss 3270' 4" @ 3343' 3000 acid Pump 30 Oil Pot 36° Gr. Comp
	<b>COMPLETED</b>

Map No. \_\_\_\_\_ Sec. 7 Twp. 23 R. 3W

Well No. 2 Botts "B"

Drillers Gas Company

FIRST REPORT

Contractor

C E L N W S E

SECTION PLAT

660 Ft. from N. Line

\_\_\_\_\_ Ft. from S. Line

\_\_\_\_\_ Ft. from E. Line

990 Ft. from W. Line


Harvey County

Location \_\_\_\_\_

Rig up \_\_\_\_\_

Drilling and Remarks:

R U R

RECORD

Cased \_\_\_\_\_ in., \_\_\_\_\_ ft.

Sand \_\_\_\_\_

Gas \_\_\_\_\_

Oil \_\_\_\_\_

Total Depth \_\_\_\_\_

PRODUCTION

1st 24 hrs. Nat. \_\_\_\_\_

1st 24 hrs. after shot \_\_\_\_\_

Gas \_\_\_\_\_ Cu. Ft.

Dry Hole \_\_\_\_\_

Abandoned \_\_\_\_\_

Date

NOV 3 1948 19

S. I. LEWIS Scout

