

KANSAS

Harvey

Section 7 Township 23 Range 3WWell No. 3 Botts "G"Company Drillers GasBurrtton
NORTH

WEST EAST

SOUTH

2

KANSAS Harvey

Sec. 7 Twp. 23 R. 3W ✓

Well No. #3 Botts "C" Farm _____

Driller Gas _____ Company _____


Burrton Pool

440' Ft. from N. Line

_____ Ft. from S. Line

_____ Ft. from E. Line

660' Ft. from W. Line

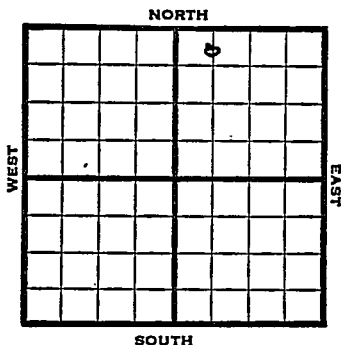

C NW NE

1949 Elev 1488' REPORT

2/16 Location
2/23 8" @ 292'
Drlg. 1260'
3/2 Miss 3334'
TD 3346'
5" @ 3345'
3/8 TD 3372
650' oil 36 hrs.

3/16 4000 acid
Pump 25 fluid a day

3/23 "

3/30 Miss 3234'
5" @ 3345'
8000 acid
Pump 30 oil Pot.
Gr. 39°
TD 3384'

COMPLETED

Map No. _____ Sec. 7 Twp. 23 R. 3W

Well No. 3 Botts "C"

_____ Drillers Gas _____ Company

FIRST REPORT _____ Contractor

C NW NE

SECTION PLAT

.440 Ft. from N. Line

_____ Ft. from S. Line

_____ Ft. from E. Line

660 Ft. from W. Line

		o	
		'	

Harvey County

Location X

Rig up _____

Drilling and Remarks:

RECORD

Cased _____ in., _____ ft.

Sand _____

Gas _____

Oil _____

Total Depth _____

PRODUCTION

1st 24 hrs. Nat. _____

1st 24 hrs. after shot _____

Gas _____ Cu. Ft.

Dry Hole _____

Abandoned _____

Date

FEB 16 1949 19

S. J. LEWIS Scout

Kansas

Map No. 29 Sec. 7 Twp. 23 R. 3WWell No. 3 Botts "C"


Drillers Gas

Company

COMPLETE

Contractor

C NW NE

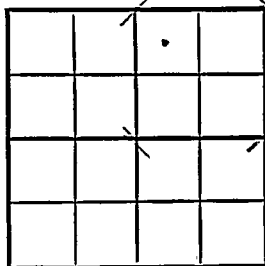211491
SECTION PLAT440 Ft. from N. Line Ft. from S. Line Ft. from E. Line660 Ft. from W. Line

Harvey County

Location Rig up

Drilling and Remarks:

*Mair 3234**5" C3345**8000 acid**Pung 30 oil Port**39 2/3*

RECORD

Cased in., ft.Sand "Gas Oil Total Depth 3354

PRODUCTION

1st 24 hrs. Nat. 1st 24 hrs. after shot Gas Cu. Ft.Dry Hole Abandoned

Date

MAR 30 1949

19

S. J. LEWIS

Scout