


Section 7 Township 23 Range 8-W

Well Number #1-Ray

Company Fred Phillips

NORTH

OFFSET

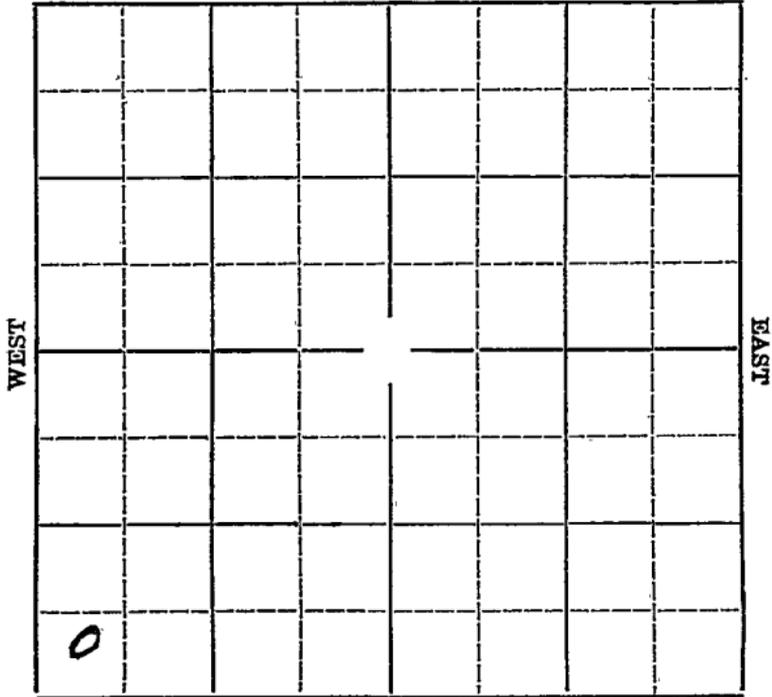

SOUTH

Sec. 7 Twp. 23 R. 8W

Well No. #1 Ray Farm


Fred Phillips Company

 Ft. from N. Line

330' Ft. from S. Line

 Ft. from E. Line

330' Ft. from W. Line

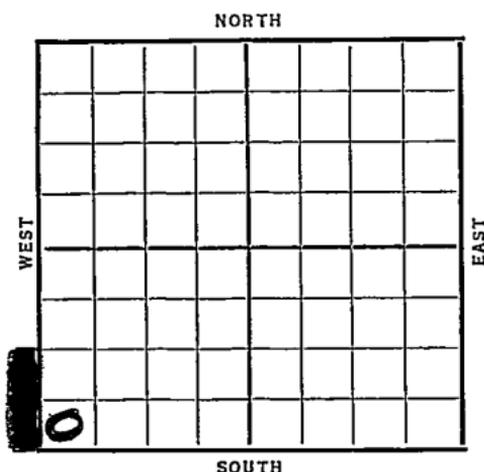

OFFSET

SPECIAL REPORT Elev. 1693

1938	8/26	Cellar.
	9/3	13" @ 200'. Waiting on cement.
	9/10	Drlg. 2160'.
	9/18	Drlg. 3095'.
	9/24	Kansas City 3220'. Drlg. 3602'.
	10/1	Chat 2703'. Cored 3705-88'. Show dead oil. Shut down.
	10-15	Top Siliceous 4098 T.D. 4161 Hole Full Water (Our Geologist Checked Samples O.K. to Plug with Mr. Scarborough Approval)
	10/21/36	Sil. 4098'. T.D. 4163'. Dry and abandoned.

ABANDONED

KANSAS

Map No. 41 Sec. 7 Twp. 23 R. 8W

Well No. 1 Ray

Fred Phillips Company

(offset) Contractor

SPECIAL

SECTION PLAT

_____ Ft. from N. Line

330 Ft. from S. Line

_____ Ft. from E. Line

330 Ft. from W. Line

FIRST REPORT

Location _____

Rig up _____

Drilling and Remarks:

Ocellar

RECORD

Cased _____ in., _____ ft.

Sand _____

Gas _____

Oil _____

Total Depth _____

PRODUCTION

1st 24 hrs. Nat. _____

1st 24 hrs. after shot _____

Gas _____ Cu. Ft.

Dry Hole _____

Abandoned _____

Date

AUG 26 1936 19

S. J. LEWIS

Scout

Map No. 41 Sec. 7 Twp. 23 R. 8W

Well No. 1 Ray

Fred Phillips Company

Contractor

SECTION PLAT

0			

_____ Ft. from N. Line

230 Ft. from S. Line

_____ Ft. from E. Line

330 Ft. from W. Line

ABANDONED

Location _____

Rig up _____

Drilling and Remarks:

Sil 4098

JH

RECORD

Cased _____ in., _____ ft.

Sand _____

Gas _____

Oil _____

Total Depth 4163

PRODUCTION

1st 24 hrs. Nat. _____

1st 24 hrs. after shot _____

Gas _____ Cu. Ft.

Dry Hole _____

Abandoned _____

Date

OCT 21 1936

S. J. LEWIS Scout