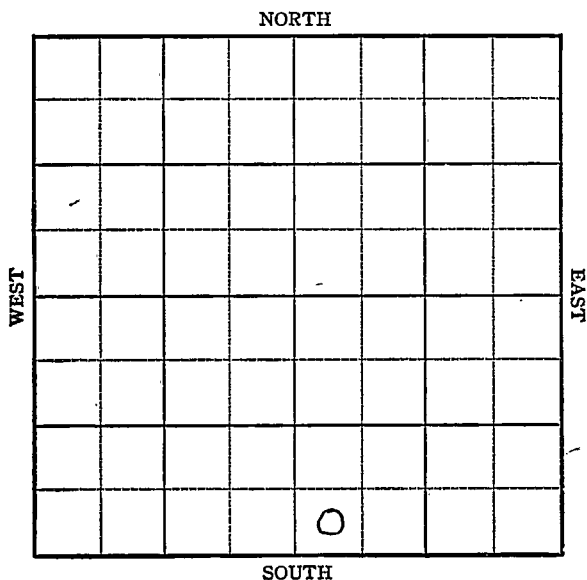


Section 7 Township 23 Range 11WWell No. 1 BrockCompany B & R et al

Sec. 7 Twp. 23 R. 11-W

Well No. #1 Brock Farm


B&R Etal Company
Wildcat

 Ft. from N. Line

330 Ft. from S. Line

 Ft. from E. Line

330 Ft. from W. Line

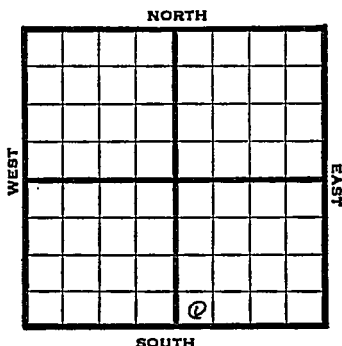

SW SE

1948

^E 11 1827'

R E P O R T

8/4

Location

8/11

"

8/18

"

8/25

8" @ 325'

Drlg 335'

9/1

Drlg. 3105'

9/8

Lansing 3307'

BKC 3551'

Arbuckle 3708'

TD 3769'

5" @ 3769'

9/15

Arb. 3708'

5 " @ 3769' TD

Perf

Aband.

ABANDONED

Stafford County Kansas State

Map No. _____ Sec. 7 Twp. 23 R. 11W

Well No. 1 Brock

B & R etal. Company

FIRST REPORT

Contractor

SW SE

SECTION PLAT

_____ Ft. from N. Line

330 Ft. from S. Line

_____ Ft. from E. Line

330 Ft. from W. Line

Wildcat

Remarks:

Location

Date
AUG 4 1948

Scout S. J. LEWIS

Stafford County Kansas State

Map No. 47 Sec. 7 Twp. 23 R. 11W

Well No. 1 Brock

B & R et al. Company

ABANDONED

ABANDONED _____ Contractor

E1, 1827.
SECTION PLAT

Ft. from N. Line

330 Ft. from S. Line

Ft. from E. Line

330 Ft. from W. Line


Brock Pool

Remarks:

Pr 73708

5-03769 AD

Perf.

Date
SEP 15 1948

Scout **S. J. LEWIS**