

Stafford

FORM 51 5M 6-46 PETROL

KANSAS

Section 7 Township 23 Range 11W

Well No. 3 Gilbert

Company Phillips

Richland NORTH

		0					

WEST

EAST

SOUTH

KANSAS

Stafford county X

Sec. 7 Twp. 23 R. 11W

Well No. 3 Gilbert Farm
Phillips Company

Richard

Ft. from N. Line


330

Ft. from S. Line

990

Ft. from E. Line

Ft. from W. Line

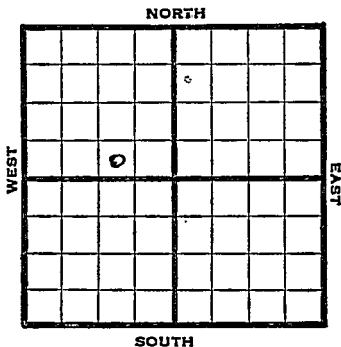

SW SE NW

1947 Elev. 1823' REPORT

5/7	Location
5/13	8" @ 449' Drlg 1640'
5/21	Simp 3641' Arb 3694 TD 3697' 5" @ 3694' RUST
5/28	" "
6/3	" "
6/10	TD 3698' 3000 Acid Shot 64 bbls. oil & 32W in 24 hrs.
6/17	" "
6/24	TD 3698'
7/1	" "
7/8	Pump 82 bbls. oil / 5W 24 hrs.

OVER

1947

7/16

Arbuckle 3694'

5" @ 3694'

3500 Acid

Pump 58 oil / 15% W.

Pot.

Gr. 28

T.D. 3698'

Complete

COMPLETED

Map No. K 47 Sec. 7 Twp. 23 R. 11W

Well No. 3 Gilbert

Phillips Company

FIRST REPORT Contractor

SW SE NW

SECTION PLAT

 Ft. from N. Line

330 Ft. from S. Line

990 Ft. from E. Line

 Ft. from W. Line

Stafford County

Location X

Rig up

Drilling and Remarks:

RECORD

Cased in., ft.

Sand

Gas

Oil

Total Depth

PRODUCTION

1st 24 hrs. Nat.

1st 24 hrs. after shot

Gas Cu. Ft.

Dry Hole

Abandoned

Date

MAY 7 1947 19

S. J. LEWIS Scout

