


Section 7 Township 23 Range 11W

Well No. #1 Minnis

Company Lion Oil

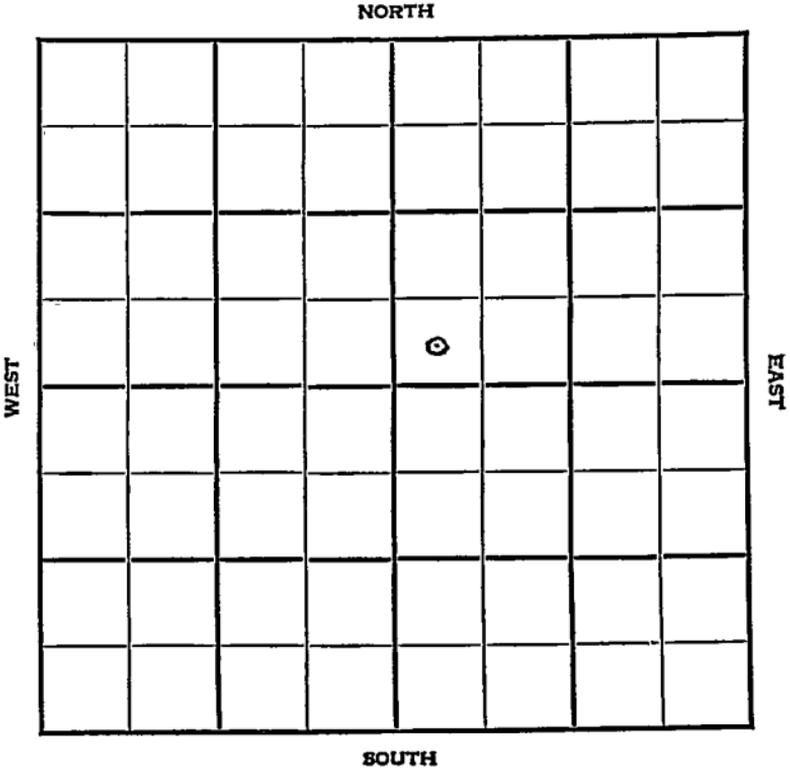

Sec. 7 Twp. 23 R. 11W

Well No. #1 Minnis Farm

Lion Oil Company


Broch

Ft. from N. Line

330 Ft. from S. Line

Ft. from E. Line

330 Ft. from W. Line

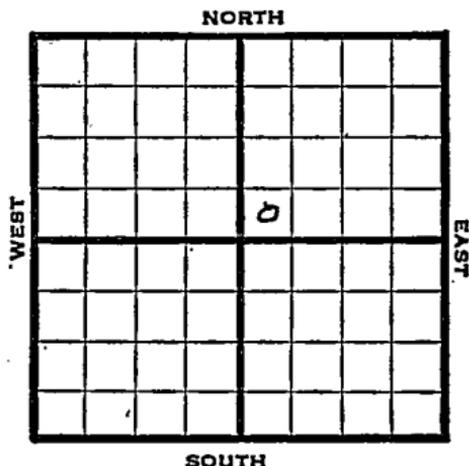

SWINE

1948 Elev. 1822' REPORT

1/21 Location

1/26 "

2/4 8" @ 434'
Lansing 3302'
Drlg. 3525'

2/11 Conglomerate 3573'
Viola 3601'
Simpson 3637'
Arbuckle 3689'
5" @ 8689'
TD 3693'

2/18 Bailed fluid PH 10% W.
Swb 12 bbls fluid PH 9 hrs. 50% W

2/25 "

3/3 Arbuckle 3689'
5" @ 3689'
Pump 90 oil & 90 W Pot.
Gr. 40°
Total Depth 3693'

COMPLETED

Map No. _____ Sec. 7 Twp. 23 R. 11W

Well No. 1 Minnis

Lion Oil Company

FIRST REPORT

Contractor _____

SW NE


SECTION PLAT

_____ Ft. from N. Line

330 Ft. from S. Line

_____ Ft. from E. Line

330 Ft. from W. Line

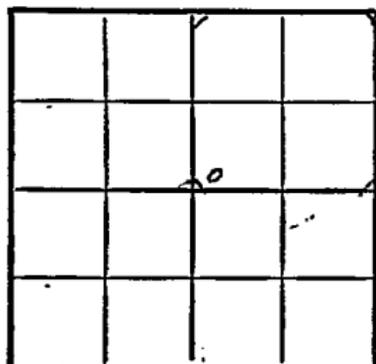

Stafford County

Location X

Rig up _____

Drilling and Remarks:

RECORD

Cased _____ in, _____ ft.

Sand _____

Gas _____

Oil _____

Total Depth _____

PRODUCTION

1st 24 hrs. Nat. _____

1st 24 hrs. after shot _____

Gas _____ Cu. Ft.

Dry Hole _____

Abandoned _____

Date

JAN 21 1948 19

S. J. LEWIS Scout

