


KANSAS STAFFORD

FORM 51 5M 11-44 PETROL

Section 7 Township 23 S Range 11 W

Well No. #1 Brinkman

Company PHILLIPS

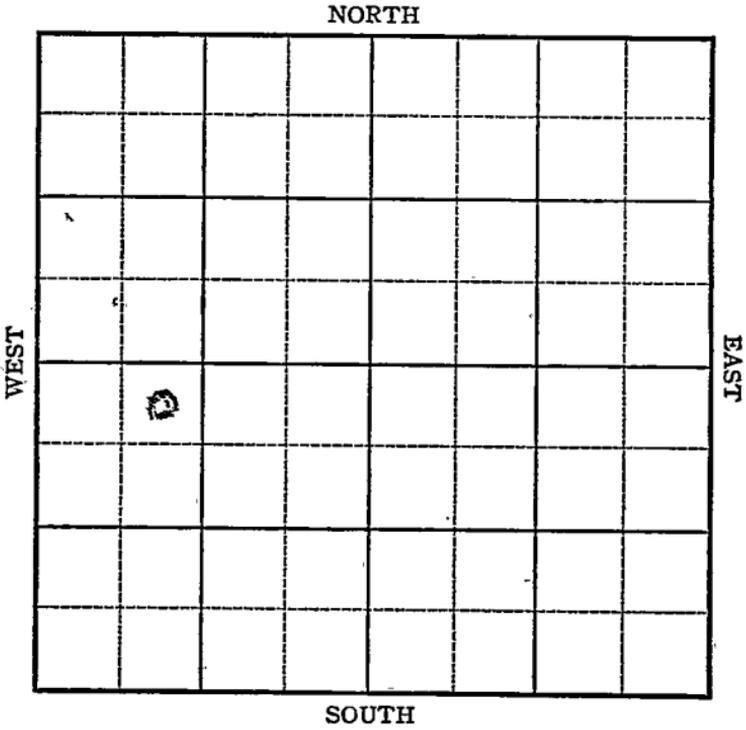

KANSAS

Stafford County

Sec. 7 Twp. 23 R. 11W

Well No. #1 Brinkman Farm _____
Phillips Company _____


Curtis

330 Ft. from N. Line

_____ Ft. from S. Line

_____ Ft. from E. Line

990 Ft. from W. Line

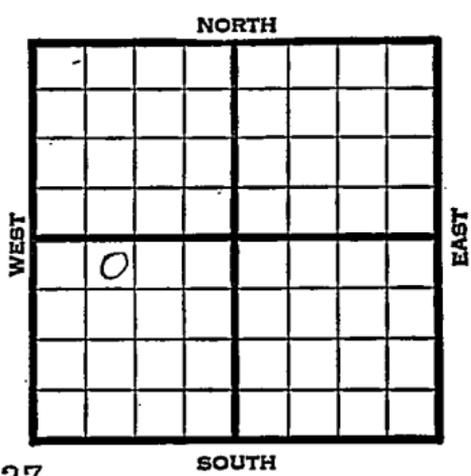

NE NW SW Elev. 1827

REPORT

1945

4/1^h Location
 4/20 RUR
 4/27 8" @ 405
 Drlg. 2368'
 5/3 Lens 3290
 Drlg. 3443 SO
 5/10 Viola 3575
 Simp 3614
 Arb 3666
 TD 3668
 5" @ 3666' RUST
 5/17 Swab 77 oil in 6 hrs.
 5/24 " " " " "
 5/31 " " " " "
 6/13 Arb. 3666
 5" @ 3666'
 Pump 292 Pet.
 28 4 Gr
 TD 3140'

COMPLETED

Pool Name Curtis

Kansas

Map No. 47 Sec. 7 Twp. 23 R. 11WWell No. 1 BrinkmanPhillips


Company

FIRST REPORT

Contractor

NE NW SW

SECTION PLAT

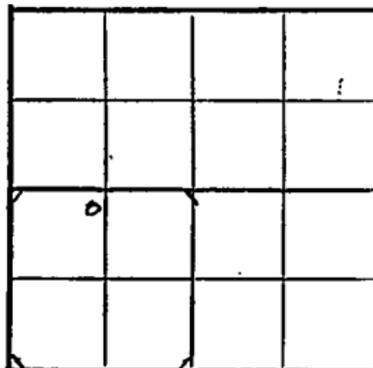330 Ft. from N. Line Ft. from S. Line Ft. from E. Line990 Ft. from W. LineStaffordLocation XRig up

Drilling and Remarks:

RECORD

Cased in., ft.Sand Gas Oil Total Depth

PRODUCTION

1st 24 hrs. Nat. 1st 24 hrs. after shot Gas Cu. Ft.Dry Hole Abandoned

Date

APR 11 1945 19S. J. LEWIS Scout

Kansas Pool Name CurtisMap No. 47 Sec. 7 Twp. 23 R. 11WWell No. 1 BrinkmanPhillips Company**COMPLETED** Contractor

NE NW SW

E 1, 1822
SECTION PLAT330 Ft. from N. Line Ft. from S. Line Ft. from E. Line990 Ft. from W. Line

o			

Stafford CountyLocation Rig up

Drilling and Remarks:

Cor 436665" C 3666Pump 292 Pot28 1/2

RECORD

Cased in., ft.Sand Gas Oil Total Depth 3140

PRODUCTION

1st 24 hrs. Nat. 1st 24 hrs. after shot Gas Cu. Ft.Dry Hole Abandoned

Date

JUN 13 1945 19S. J. LEWIS Scout