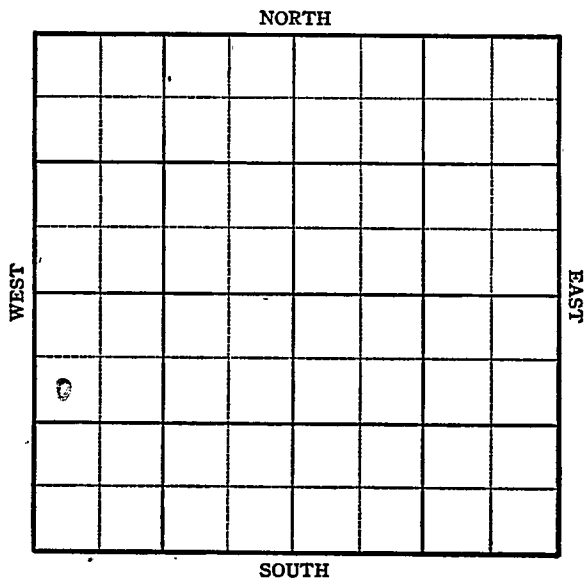


KANSAS

Stafford

Section 7 Township 23 Range 11WWell No. 2 BrinkmanCompany Phillips

KANSAS Stafford

Sec. 7 Twp. 23 R. 11-W

Well No. #2 Brinkman Farm


Phillips Company

990 Ft. from N. Line

 Ft. from S. Line

/ Ft. from E. Line

330 Ft. from W. Line

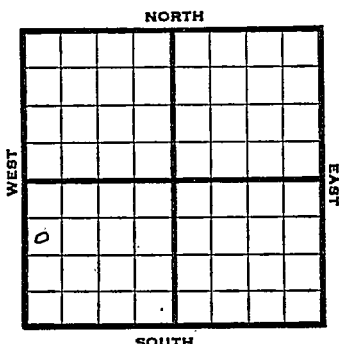

SW NW SW

1945 Elev. 1836' REPORT

10/17 Location

10/24 8" @ 417

Drlg. 1352

10/31 Drlg. 3146

11/3 Lans 3312

Viola 3589

Arb. 3681

TD 3683

5" @ 3681 RUST

11/14 " " "

11/21 TD 3687

1000 acid.

Swab 8 oil per hr. 2 hrs.

11/28 " " " " "

12/5 " " " " "

12/12 " " " " "

12/19 Arb. 3681

5" @ 3681

1000 acid

TD 3687

Pump 168 Pot.

Grav. 33.0

COMPLETED

KANSAS

Kansas Pool Name CurtisMap No. 47 Sec. 7 Twp. 23 R. 11WWell No. 2 BrinkmanPhillips

Company

FIRST REPORT

Contractor

SW NW SW

SECTION PLAT

990 Ft. from N. Line Ft. from S. Line Ft. from E. Line330 Ft. from W. Line

a			

Stafford CountyLocation XRig up

Drilling and Remarks:

RECORD

Cased in., ft.Sand Gas Oil Total Depth

PRODUCTION

1st 24 hrs. Nat. 1st 24 hrs. after shot Gas Cu. Ft.Dry Hole Abandoned

Date

OCT 17 1945

19

S. J. LEWIS

Scout

KANSAS Kansas Pool Name CurtisMap No. K-47 Sec. 7 Twp. 23 R. 11WWell No. 2 BrinkmanPhillips Company

COMPLETED


Contractor

SW 1W SW

E11836
SECTION PLAT990 Ft. from N. Line

Ft. from S. Line

Ft. from E. Line

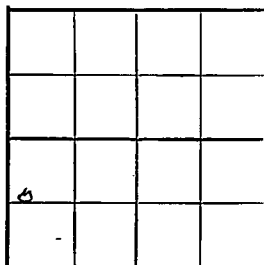330 Ft. from W. Line

Stafford County

Location

Rig up

Drilling and Remarks:

Cir 83687
5" 83687
1000 sand
Pump 168, 28

330 = 28

RECORD

Cased _____ in., _____ ft.

Sand _____

Gas _____

Oil _____

Total Depth 3687

PRODUCTION

1st 24 hrs. Nat. _____

1st 24 hrs. after shot _____

Gas _____ Cu. Ft.

Dry Hole _____

Abandoned _____

Date

DEC 19 1945 19 S. I. LEWIS Scout

O.W.W.O.

FORM 513 SUNRAY

County Stafford Elev. 1836 DFSec. 7 Twp. 23 Rgs. 11WCompany PhillipsFarm Name Brinkman No. 2

TOPS

DEPTH

LOG

DATUM

Loc. in Sec.

Anh.

SW NW SW

Tp.

H.

Tr.

Dg.

BL.

L.

3312

K.C.

B.K.C.

Ce.

C.

M.

M.

K.

Mz.

Mo.

V.

S.

S.

A.

R.

Pe.

G.

Geol.

O.W.W.O.

Contr.

Pool

Brock

MAR 6 '57

FIRST REPORT

COMPLETE

T.D. OTD

3709

Date Comm.

5" @ 3681, New Info.- MICT, PB 3440, 32/

3374-82, Swb 25.62 BW/4 hrs + SO, Swb 6 $\frac{1}{2}$ bo
+ 37 $\frac{1}{2}$ bw o hrs, P/3 bo + 40 bw/24 hrs, P/2
bo + 32 bw/24 hrs, from LKC /3374-82

COMPLETE

15