
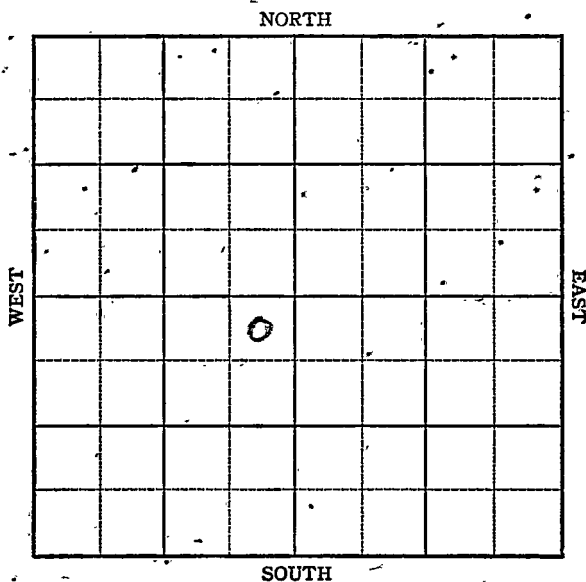


Section 7 Township 23 Range 11-W

Well No. #3 Brinkman

Company Phillips

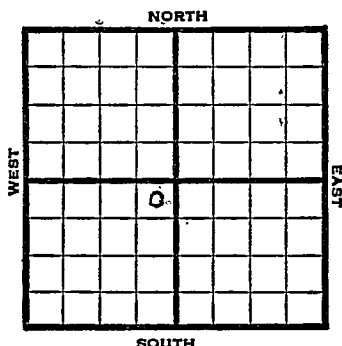

Sec. 7 Twp. 23 R. 11-WWell No. #3 Brinkman FarmPhillips Company330 Ft. from N. Line Ft. from S. Line330 Ft. from E. Line Ft. from W. Line

NE SW

1947

1226

REPORT

2/5

Location

2/12

" "

2/19

8" @ 404'
Drlg 1820'

2/26

Lens 3295
3525' Drlg

3/4

BKC 3531'
Viola 3608
Arb 3700-02
TD 3702'
5" @ 3700'
RUST

3/11

TD 3702'

3/18

Swb 91 bbls oil & 7 bbls water in
3 hrs

3/25

Swb 16 oil & 15 W PH

4/2

" " "

4/9

" " "

4/15

" " "

4/23

2" " "

4/29

" " "

OVER

5/7

Arb 3700

5" @ 3700'

Pump 159 oil & 1 water

Grav. 39.9

TD 3702'

COMPLETED

Map No. A 7 Sec. 7 Twp. 23 R. 11WWell No. 3 Brinkman

Phillips

Company

FIRST REPORT

Contractor

NE SW

SECTION PLAT


330 Ft. from N. Line

Ft. from S. Line

330 Ft. from E. Line

Ft. from W. Line

Stafford County

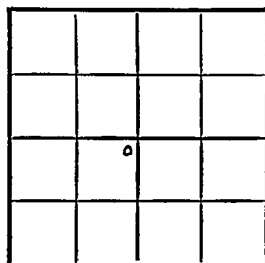Location X

Rig up

Drilling and Remarks:

RECORD

Cased _____ in., _____ ft.

Sand _____

Gas _____

Oil _____

Total Depth _____

PRODUCTION

1st 24 hrs. Nat. _____

1st 24 hrs. after shot _____

Gas _____ Cu. Ft.

Dry Hole _____

Abandoned _____

Date

FEB 5 1947 19

S. J. LEWIS

Scout

Map No. 47 Sec. 7 Twp. 23 R. 11WWell No. 3 BrinkmanPhillips

Company

CORRECTION

Contractor

NE NW

SECTION PLAT

330 Ft. from N. Line

Ft. from S. Line

330 Ft. from E. Line

Ft. from W. Line

Stafford County

Location

Rig up

Drilling and Remarks:

Reported

8-23-11W

RECORD

Cased _____ in. _____ ft.

Sand _____

Gas _____

Oil _____

Total Depth _____

PRODUCTION

1st 24 hrs. Nat. _____

1st 24 hrs. after shot _____

Gas _____ Cu. Ft.

Dry Hole _____

Abandoned _____

Date

FFR 1 9 1947 19

S. I. LEWIS

Scout

Map No. K47 Sec. 7 Twp. 23 R. 11W

Well No. 3 Brinkman

Phillips Company

COMPLETE

Contractor

NE SW

E1, 1826
SECTION PLAT

330 Ft. from N. Line

 Ft. from S. Line

330 Ft. from E. Line

 Ft. from W. Line

	6		

Stafford County

Location

Rig up

Drilling and Remarks:

Per X3700
5' @ 3700
Pump 159 oil +
1 water

37 2 1/2

RECORD

Cased in., ft.

Sand

Gas

Oil

Total Depth 3702

PRODUCTION

1st 24 hrs. Nat.

1st 24 hrs. after shot

Gas Cu. Ft.

Dry Hole

Abandoned

Date

MAY 7 1947