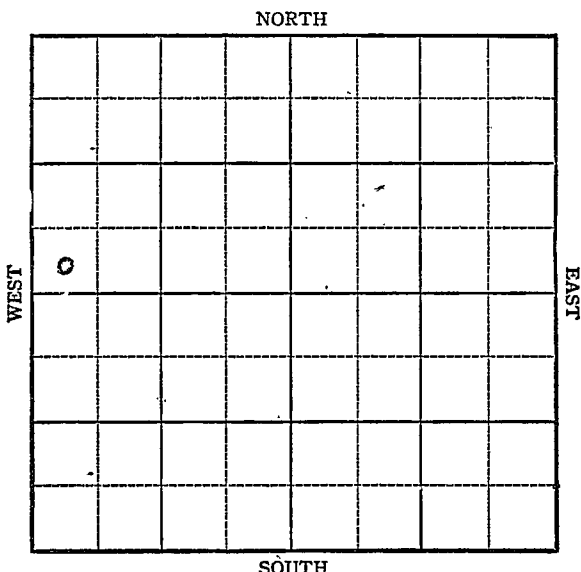


KANSAS

Stafford

Section 7 Township 23 Range 11WWell No #1 GilbertCompany Phillips

KANSAS

Stafford

Sec. 7 Twp. 23 R. 11W

Well No. #1 Gilbert Farm

Phillips

Company


Brock

 Ft. from N. Line

330 Ft. from S. Line

 Ft. from E. Line

330 Ft. from W. Line

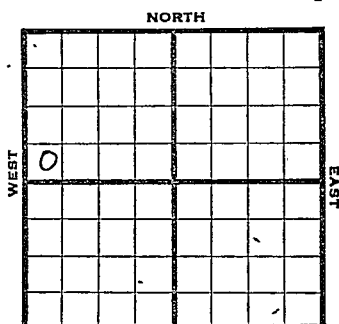

SW -NW Elev. 1830

1944

R E P O R T

12/20

Location

12/29

8" @ 411' Drlg.. 1668'

1945

1/3

Lans 3301 Drlg 3407

1/10

Viola 3585

Simp 3635

Arb 3697

TD 3704

1/17

5" @ 3698 Rust
" " " "

1/26

TD 3704 300 acid
Swb. 20 oil PH 4 hrs.

1/31

" " " " "

2/7

" " " " "

2/14

" " " " "

2/21

Arb. 3697
5" @ 3698'
3000acid
Pump 449 Pot.
TD 3704
Grav. 39.4

COMPLETED

Pool Name BrockMap No. 47 Sec. 7 Twp. 23 R. 11WWell No. 1 GilbertPhillips


Company

FIRST REPORT

Contractor

SW NW

SECTION PLAT

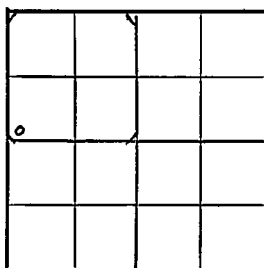 Ft. from N. Line330 Ft. from S. Line Ft. from E. Line330 Ft. from W. LineStaffordLocation Rig up

Drilling and Remarks:

RECORD

Cased in., ft.Sand Gas Oil Total Depth

PRODUCTION

1st 24 hrs. Nat. 1st 24 hrs. after shot Gas Cu. Ft.Dry Hole Abandoned

Date

DEC 20 194419S. J. LEWISScout

Pool Name BrockMap No. 47 Sec. 7 Twp. 23 R. 11WWell No. 1 GilbertPhillips CompanyCOMPLETED Contractor

SW NW

SECTION PLAT

b			

 Ft. from N. Line330 Ft. from S. Line Ft. from E. Line330 Ft. from W. LineStaffordLocation Rig up

Drilling and Remarks:

Ar 3697
5" 3698
3000 cu ft
Pump 449 R

39" 36

RECORD

Cased in., ft.Sand Gas Oil Total Depth 3704

PRODUCTION

1st 24 hrs. Nat. 1st 24 hrs. after shot Gas Cu. Ft.Dry Hole Abandoned

Date

FEB 21 1945

19

S. J. LEWIS

Scout