


Stafford

KANSAS

SECTION 7 TOWNSHIP 23 RANGE 11W

WELL NO. #1 Minnis

COMPANY Petroleum Management etal

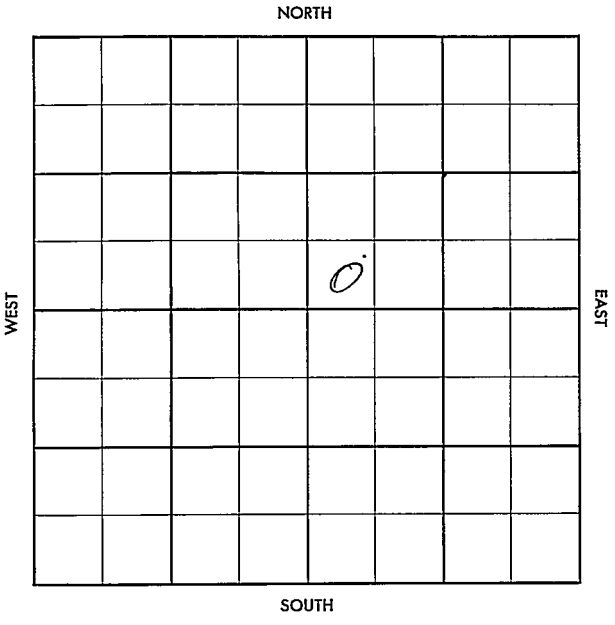

County Stafford Elev. 1820
 Sec. 7 Twp. 23S Rge. 11W
Twin to plugged well

| TOPS | DEPTH | LOG | DATUM | Loc. in Sec. | | |
|------------|-------|------|-------|--|------------|---|
| Anh. | | | | SW NE | | |
| Tr. | | | | | | |
| H. | 3126 | | | 65' FSL X | | |
| Tr. | 3148 | | | 45' FSL OF | | |
| Dg. | 3163 | | | NE/11 | | |
| Bl. | 3265 | | | | | |
| L. | 3293 | | | | | |
| K.C. | | | | Geol. | | |
| B.K.C. | | 3549 | | Contr. | | |
| Ce. | | | | Price Duly | | |
| C. | | | | | | |
| M. | | | | Pool | | |
| M. | | | | Brook | | |
| K. | | | | | | |
| Mz. | | | | | | |
| Ma. | | | | | | |
| V. | 3597 | 3599 | | <table border="1"> <tr> <td>OCT 24 '55</td> </tr> <tr> <td>0</td> </tr> </table> | OCT 24 '55 | 0 |
| OCT 24 '55 | | | | | | |
| 0 | | | | | | |
| S. | 3637 | 3638 | | | | |
| S. | | | | | | |
| A. | 3695 | 3695 | | | | |
| R. | | | | | | |
| PE. | | | | | | |
| G. | | | | | | |
| TD. | 3731 | | | ABANDONED | | |

Date Comm. 10-1-56 Lien - 70
 #11 20' w/225; D 2055 DE 17 WF

DST 3470 - 3457-70 op 1 hr
20' Md (VSSQ) BHP 0, DST
3596-3636 1 hr 2000 SW BHP
124.0 DST OCT 24 '55 3596-3699
1 hr 155' OEG CMW + 320' W5
1180/20
D & C