

KANSAS

Stafford


Section 7 Township 23 Range 12WWell No. 1 JamesonCompany C U Bay

Wildcat

NORTH

WEST

EAST

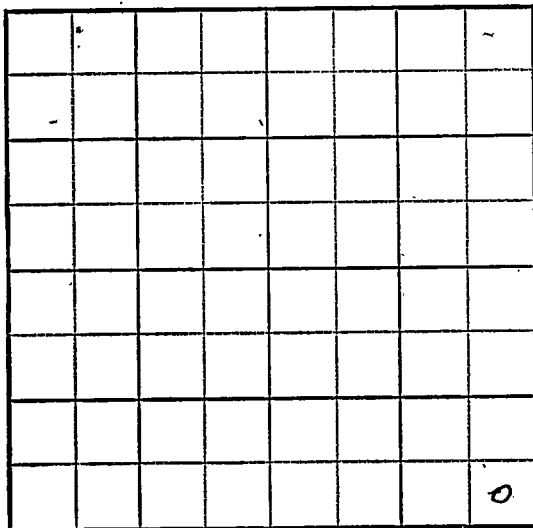

SOUTH



Sec. 7 Twp. 23 R. 12W

Well No. #1 Jameson Farm
C. U. Bay Company

Wildcat

 Ft. from N. Line

330'


 Ft. from S. Line

330'

 Ft. from E. Line

 Ft. from W. Line

SE/C

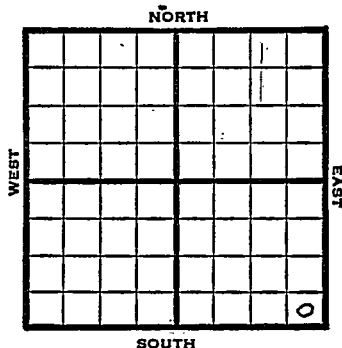

1948	Eli 1865'	REPORT
12/8	RUR	
12/14	Drlg. 2422'	
	8" @ 251'	
12/22	Lansing 3402'	
	Conglomerate 3672'	
	Drlg. 3707'	
12/29	TD 3888'	
	Simp 3795'	
	Arb. 3854'	
	Aband.	
	ABANDONED	

Map No. _____ Sec. 7 Twp. 23 R. 12W

Well No. 1 Jameson

C. U. Bay Company

FIRST REPORT

Contractor

SE/C


SECTION PLAT

_____ Ft. from N. Line

330 Ft. from S. Line

330 Ft. from E. Line

_____ Ft. from W. Line

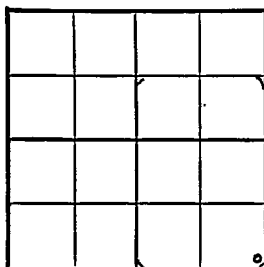

Stafford County

Location _____

Rig up _____

Drilling and Remarks:

R U R

RECORD

Cased _____ in., _____ ft.

Sand _____

Gas _____

Oil _____

Total Depth _____

PRODUCTION

1st 24 hrs. Nat. _____

1st 24 hrs. after shot _____

Gas _____ Cu. Ft.

Dry Hole _____

Abandoned _____

Date

DEC 8 1948 19

S. J. LEWIS Scout

Map No. 47 Sec. 7 Twp. 23 R. 12W

Well No. 1 Jameson

C. U. Bay

Company

ABANDONED

Contractor

SE/C


E 11865
SECTION PLAT

 Ft. from N. Line

330 Ft. from S. Line

330 Ft. from E. Line

 Ft. from W. Line

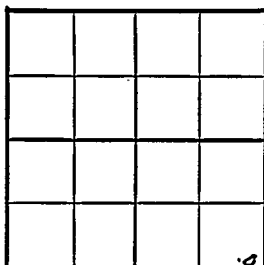

Stafford County

Location

Rig up

Drilling and Remarks:

Drill 3795
Dr 37954

RECORD

Cased in., ft.

Sand

Gas

Oil

Total Depth 3795

PRODUCTION

1st 24 hrs. Nat.

1st 24 hrs. after shot

Gas Cu. Ft.

Dry Hole

Abandoned

Date

DEC 29 1948

19

S. J. LEWIS

Scout