
DX 78-1 PAWNEE KANSAS

Section 7 Township 23 Range 17W

Well No. 3 Godffey "A"

Company Phillips Pet.

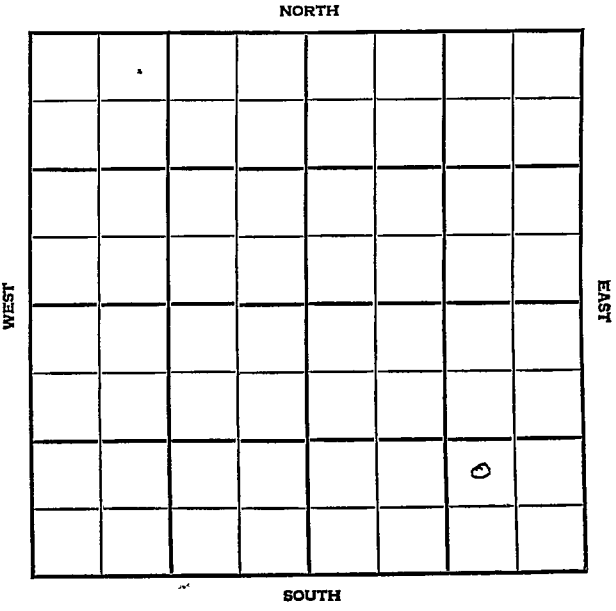

16

Pawnee KANSAS

SEC.	TWP.	R.
7	23	17W

WELL NO.

3 Godfrey "A" FARM

COMPANY

Phillips Petr.

CONTRACTOR

Co. Tools

Garfield Pool


_____ Ft. from N. Line

990 Ft. from S. Line

990 Ft. from E. Line

_____ Ft. from W. Line

NW SE SE

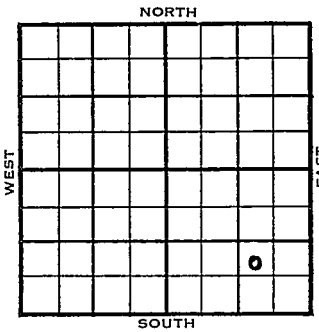

1955	ELEVATION 2083' REPORT
3/30	Spud 3-28-55 Drlg. 252'
5/25	Heeb 3654; Tor 3674; Doug 3684; Br Ls 3758; Lsg 3766; BKC 4055; Marm 4071; Chero Sh 4194; Congl 4212; Viola Chert 4361; Viola Cry 4379; TD 4390; 9 5/8" 857 7" 4377; CO 4349; 56/4232-48; swb 8 bo no wtr 2 hrs; swb 84 bo no wtr; 18 hrs; frac; flo 138 bo no w wtr. 4 hrs; flo 14 bo no wtr 10 min, 24/4220'-26; 12/4214-17, frac flo 408 bo no wtr 9 hrs; BHB 3000 bopd no wtr from Basal Penn sd 4214-48
	COMPLETED

DX-78

FORM 275 FOR SALE BY KANSAS BLUE PRINT CO.


County Pawnee State Kansas

Sec. 7 (Blk. Twp.) 23 (Sur. Rge.) 17W Map No.

Operator Phillips Pet.

Well No. 3 Farm Godfrey "A"

Elev. Location NW SE SE

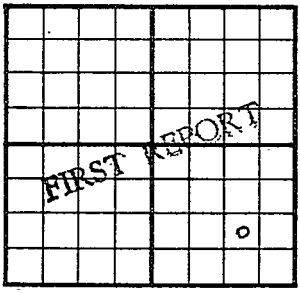

990 Ft. From S Line SE

990 Ft. From E Line Quarter

1st. Report MAR 3 0 1955

Completion

Remarks Co. tools

Spudding Date 3-28-55

Drlg. Data Garfield Pool

drlg. 252

FABEN GILSTRAP