


Section 7 Township 23 Range 17 W

Well No. #5 Scharz

Company Alpine Oil & Royalty

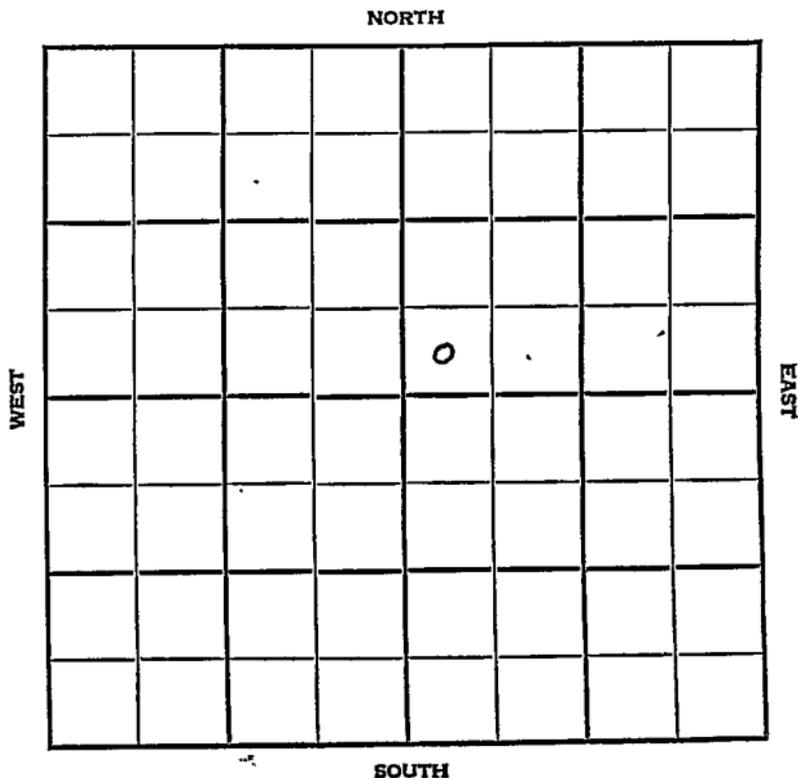

SEC. 7	TWP. 23	R. 17W
-----------	------------	-----------

WELL NO. #5 Schartz FARM

COMPANY Alpine Oil & Royalty

CONTRACTOR Quaker

	Garfield	
_____	Ft. from N. Line	<table border="1"> <tr><td></td><td></td><td></td><td></td><td></td><td></td></tr> <tr><td></td><td></td><td></td><td></td><td></td><td></td></tr> <tr><td></td><td></td><td></td><td>0</td><td></td><td></td></tr> <tr><td></td><td></td><td></td><td></td><td></td><td></td></tr> <tr><td></td><td></td><td></td><td></td><td></td><td></td></tr> <tr><td></td><td></td><td></td><td></td><td></td><td></td></tr> <tr><td></td><td></td><td></td><td></td><td></td><td></td></tr> <tr><td></td><td></td><td></td><td></td><td></td><td></td></tr> </table>																0																																
				0	
_____	Ft. from S. Line	
_____	Ft. from E. Line	
_____	Ft. from W. Line	
SW SW NE	

1956	ELEVATION 2072	REPORT
------	-------------------	--------

2-22 Comm. 2-21-56
8 5/8" @ 205
WOC

4-18 DST 4198-4248 op 1 hr. rec. 60' mco
110/45"
DST 4250-88 op 1 hr. rec. 275' socm
900/20"
5 1/2" @ 4359 w/175
CO to 4284, 72/ 4278-90
B/ 14 bw 4 hrs., 500 A
FU 800' wtr.
CO to 4260, 96/ 4238-54, 500 A, frac
S/ 10 bo, 20 bw 12 hrs.
Comp. 186 bopd, 5% wtr.
Anh. 1115
H. 3650
BL. 3754
L. 3763
BKC 4057
G. Shly 4198
Cong ch. 4257
Mz. 4280
TD 4360

COMPLETED

County Parnee Elev. 2072
 Sec. 7 Twp. 23 Rge. 17W
 Company Alpine Oil & Royalty
 Farm Name Schartz No. 5

TOPS	DEPTH	LOG	DATUM	Loc. in Sec.
Anh.	<u>1115</u>			SW SW NE
TP.				
H.	<u>3650</u>			
Tr.				
Dg.				
BL.	<u>3754</u>		<u>11682</u>	
L.	<u>3763</u>		<u>11691</u>	
K.C.				Geol.
B.K.C.	<u>4057</u>		<u>1985</u>	Contr.
Ce.				
C.	<u>4198</u>		<u>2126</u>	Quaker
M. <i>Shely</i>	<u>4257</u>		<u>2185</u>	Garfield
M. <i>Cony Jr.</i>				
M.				
K.				
Mz.	<u>4280</u>		<u>2208</u>	
Me.				
V.				
S.				
S.				
A.				
R.				
PE.				
G.				
TD.	<u>4360</u>			

COMPLETE

Date Comm. 2-21-56 APR 1 1956
8 5/8" @ 205 DST 4198-4248
 open 1 hr. rec. 60' mco 110/45"
 DST 4250-88 open 1 hr. rec. 275' socm
 900/20" 5 1/2" @ 4359/175 CO to 4284
 72/ 4278-90 B/ 1 1/4 bw 4 hr. 500 A
 FU 800' wtr. CO to 4260 96/ 4238-54
 500 A frac S/ 10 bo 20 bw 12 hr.
 Comp. 186 bopd 5% wtr.

County Parnee Elev. _____
 Sec. 7 Twp. 23 Rge. 17W
 Company Alpine Oil & Royalty
 Farm Name Schartz No. 5

TOPS	DEPTH	LOG	DATUM
Anh.			
Tr.			
H.			
Tr.			
Dg.			
Bl.			
L.			
K.C.			
B.K.C.			
Ce.			
C.			
M.			
M.			
K.			
Mz.			
Me.			
V.			
S.			
S.			
A.			
R.			
Pe.			
G.			
T.D.			

Loc. in Sec. _____
 SW SW NE
 Geol. _____
 Contr. _____
 Quaker
 Pool _____
 Garfield
 FIRST REPORT
 FEB 22 '56

Date Comm. 2-21-56
8 5/8" @ 205/ WOC

[Handwritten signature]

Co.
 Lse.
 No.
 Sec.
 T.
 R.