


Section 7 Township 23 Range 32 W

Well No. #1 Hahn Gas Unit "B"

Company Stanolind

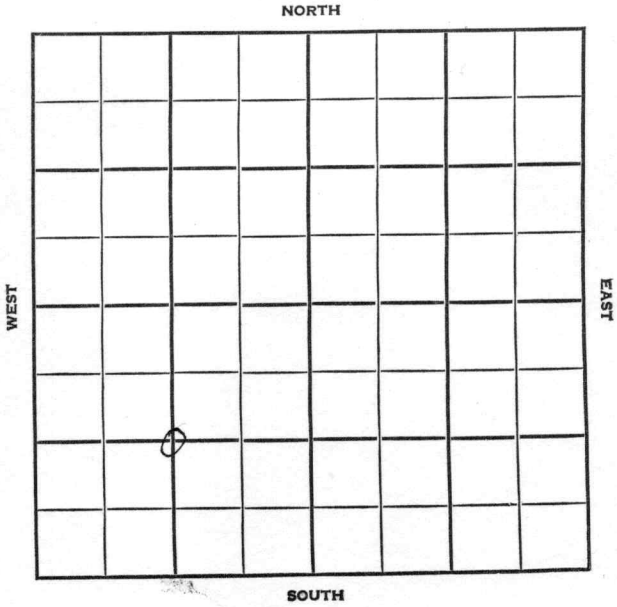

Finney

KANSAS

SEC.	TWP.	R.
7	23	32W

WELL NO. #1 Hahn Gas Unit FARM

COMPANY Stanolind

CONTRACTOR Noble


Hugoton

\_\_\_\_\_ Ft. from N. Line

\_\_\_\_\_ Ft. from S. Line

\_\_\_\_\_ Ft. from E. Line

\_\_\_\_\_ Ft. from W. Line

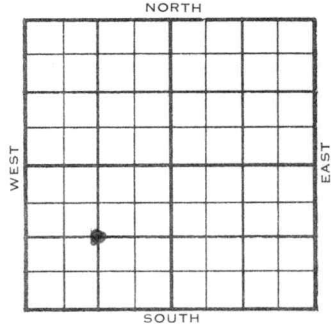

C SW/4

1955	ELEVATION	REPORT
		FIRST REPORT

8/10	Comm: 8-5-55 8" @1011/500 Red Bed: 978
------	--

County **Finney** Elev. \_\_\_\_\_  
 Sec. **7** Twp. **23** Rge. **32W**  
 Company **Stanolind**  
 Farm Name **Hahn Gas Unit "B"** No. **1**

TOPS	DEPTH	LOG	DATUM
Anh.			
TP.			
H. <i>Red Bed</i>	<i>978</i>		
Tr.			
Dg.			
Bl.			
L.			
K.C.			
B.K.C.			
Ce.			
C.			
M.			
M.			
K.			
Mz.			
Me.			
V.			
S.			
S.			
A.			
R.			
PE.			
G.			
T.D.			

Loc. in Sec. **C SW/4**  
 Geol. \_\_\_\_\_  
 Contr. \_\_\_\_\_  
**Noble**  
 Pool **Hugoton**

PROPERTY REPORT  
 AUG-10-55

Date Comm. **8-5-55**  
**8" @ 1011/500**

*25*

Co.  
Lse.  
No.  
Sec.  
T.  
R.