


Section 7 Township 23 Range 32 W

Well No. #1 Hahn Gas Unit "B"

Company Stanolind

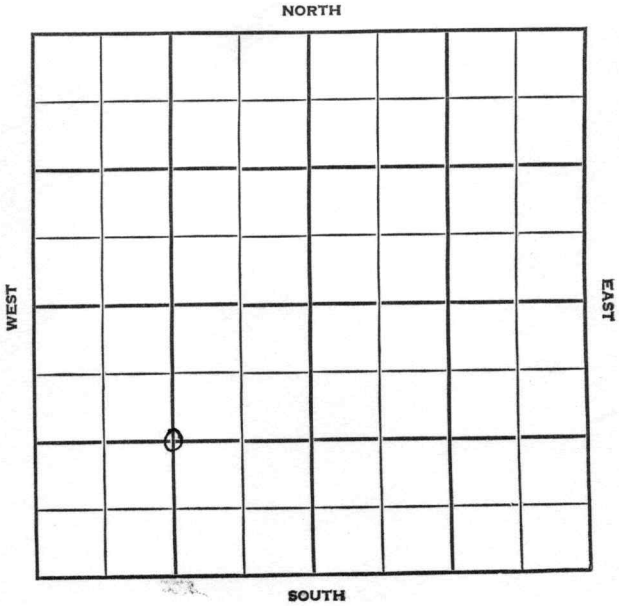

Finney

KANSAS

SEC. 7	TWP. 23	R. 32W
-----------	------------	-----------

WELL NO. #1 Hahn Gas Unit "B" FARM

COMPANY Stanolind

CONTRACTOR Noble

Hugoton


\_\_\_\_\_ Ft. from N. Line

\_\_\_\_\_ Ft. from S. Line

\_\_\_\_\_ Ft. from E. Line

\_\_\_\_\_ Ft. from W. Line

C SW/4

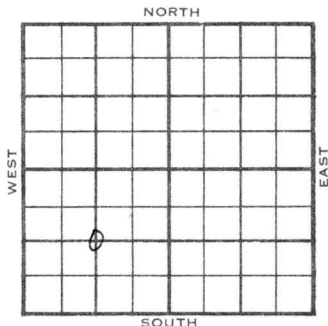

1955	ELEVATION	REPORT
------	-----------	--------

8-24

Comm. 8-5-55  
 8" @ 1011/500  
 5 1/2" @ 2573/600  
 CO 124/ 2525-56, frac, 5,257 mcfg  
 Comp. 9,121 mcfgpd  
 H. Redbed, 978 , B.L. Herr-Kri 2513  
 T.D. 2574

**FIRST REPORT**

*✓*

**COMPLETED**

County Finney Elev. \_\_\_\_\_  
 Sec. 7 Twp. 23 Rge. 32W  
 Company Stanolind  
 Farm Name Hahn Gas Unit "B" No. 1

TOPS	DEPTH	LOG	DATUM	Loc. in Sec.
Anh.				C SW/4
Tp.				
H. <u>Red Bed</u>	<u>978</u>			
Tr.				
Dg.				Geol. _____ Contr. _____ Noble Pool Hugoton
B.L. <u>Henn-Kai</u>	<u>2573</u>			
L.				
K.C.				
B.K.C.				
Ce.				
C.				
M.				
M.				
K.				
Mz.				<div style="border: 1px solid black; padding: 5px; text-align: center;"> <p><b>FIRST REPORT</b></p> <p><b>COMPLETE</b></p> </div>
Mq.				
V.				
S.				
S.				
A.				
R.				
Pe.				
G.				
T.D.	<u>2574</u>			

Date Comm. 8-5-55 AUG 24 1955  
8" @ 1011/500 5 1/2" @ 2573/600 C<sup>0</sup>  
12 1/4 / 2525-56 frac 5,257 mcfg  
Comp. 9,121 mcfgpd

Co.  
Lse.  
No.  
Sec.  
T.  
R.