


Section 7 Township 23 Range 35W

Well No. 1-A Molz

Company Stanolind Oil and Gas Company

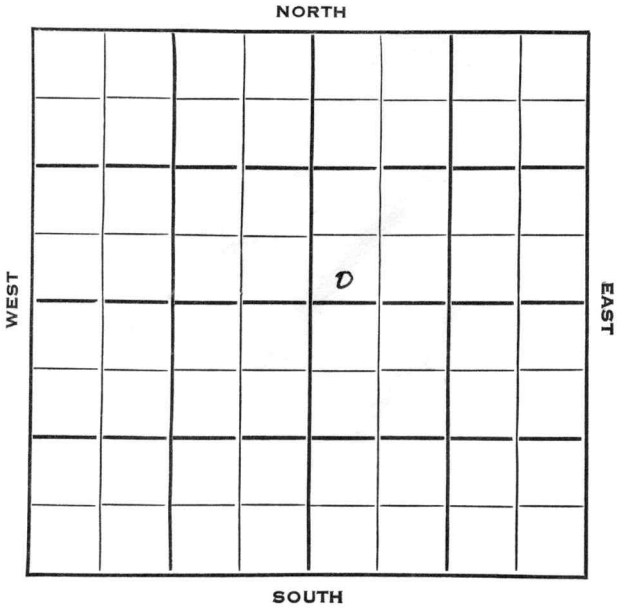

Sec. 7 Twp. 23 R. 35W

Well No. #1-A Molz Farm \_\_\_\_\_

Stanolind Company \_\_\_\_\_

Contractor \_\_\_\_\_


\_\_\_\_\_ Ft. from N. Line

150 Ft. from S. Line

\_\_\_\_\_ Ft. from E. Line

150 Ft. from W. Line

SW NE

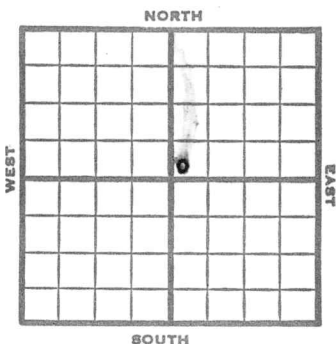

1953 Elev. 3092' REPORT

1/14 Location

1/22 8" @ 793  
Her Kr 2542, Win 2602  
RTD 2627  
5" @ 2602, WOC

1/29 NR  
2/5

2/12 60/2544-54, 48/2559-67, 24/2570-74

2/19 NR

2/25 Spud 1-7-53  
Gas Well  
TD 2627  
8" @ 793  
Her 2542, Win 2602,  
TD 2627  
5" @ 2602  
60/2544-54, 48/2559-67  
24/2570-74 sd-frac  
Comp. opn flow 9,978,000 gas  
410#

COMPLETED



