

KANSAS ^{Harvey}


Section 8 Township 23 Range 3-W

Well No. #2 Short

Company S Lebow

Burrtton Pool

NORTH

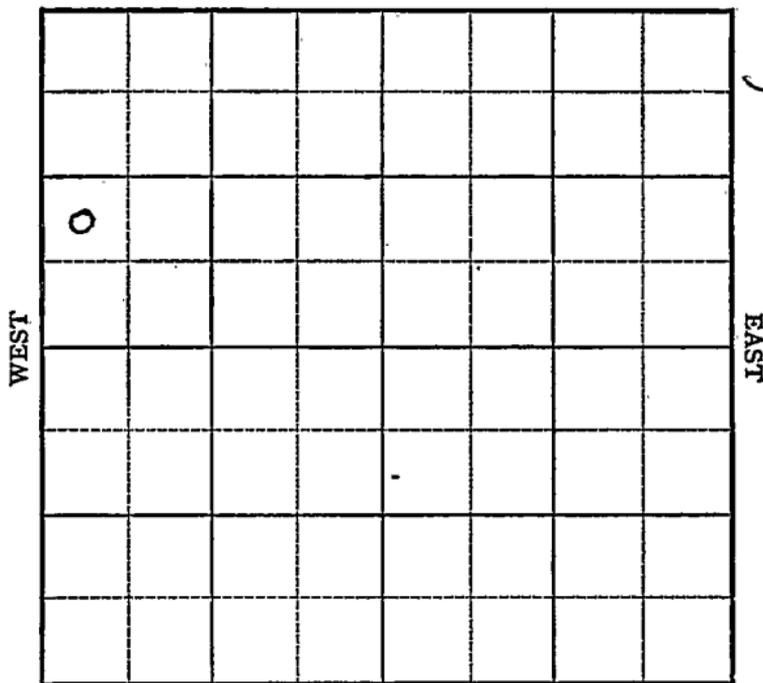

SOUTH

Sec. 8 Twp. 23 R. 3W

Well No. 2 Short Farm _____

S. Lebow Company _____

Burrton Pool


Contr. - Lebow

_____ Ft. from N. Line

990 Ft. from S. Line

_____ Ft. from E. Line

330 Ft. from W. Line

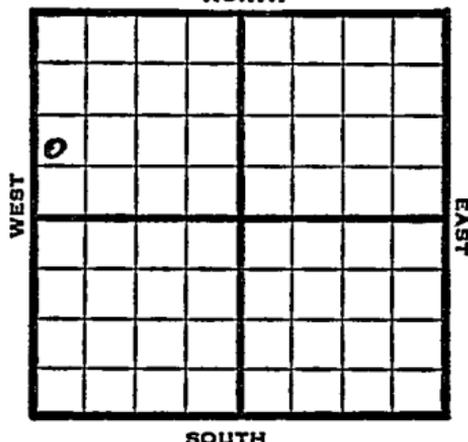

NW SW NW

SOUTH

1949

Elev 1487'

REPORT

8/24

Loc.

8/31

8" @ 305'

Drlg 2685'

9/7

Miss 3344'

TD 3376'

5" @ 3369'

9/14

TD 3379'

9/21

TD 3379'

Miss 3344'

5" @ 3369'

3000 acid

Pump 40 Oil / 5 W Pot

36° Gr.

Comp

COMPLETED

Map No. _____ Sec. 8 Twp. 23 R. 3W

Well No. 2 Short

S. Lebow _____ Company.

Lebow _____ Contractor

NW SW NW

FIRST REPORT
SECTION PLAT

_____ Ft. from N. Line

990 _____ Ft. from S. Line

_____ Ft. from E. Line

330 _____ Ft. from W. Line

o			

Harvey County

Location X

Rig up

Drilling and Remarks:

RECORD

Cased _____ in., _____ ft.

Sand _____

Gas _____

Oil _____

Total Depth _____

PRODUCTION

1st 24 hrs. Nat. _____

1st 24 hrs. after shot _____

Gas _____ Cu. Ft.

Dry Hole _____

Abandoned _____

Date

AUG 24 1949 19

S. J. LEWIS Scout

Kansas

Map No. K 39 Sec. 8 Twp. 23 R. 3W

Well No. 2 Short

S. Lebow Company

COMPLETE Contractor

NT SW NW

E 11487
SECTION PLAT

4			

Ft. from N. Line

990 Ft. from S. Line

Ft. from E. Line

330 Ft. from W. Line

Harvey County

RECORD

Location _____

Cased _____ in., _____ ft.

Rig up _____

Sand _____

Drilling and Remarks:

Gas _____

Misc 3344

Oil _____

5" @ 3368

Total Depth 3328

3500 acid

PRODUCTION

Pump 40 oil + 15W

1st 24 hrs. Nat. _____

BT

1st 24 hrs. after shot 1100

26 1/2 cu

Gas _____ Cu. Ft.

Dry Hole _____

Abandoned _____

Date

SEP 21 1949 19

S. J. LEWIS Scout