

KANSAS


Harvey Co.

Section 8 Township 23 Range 3W

Well No. #3 Brown

Company S. Lebow

Burrton pool

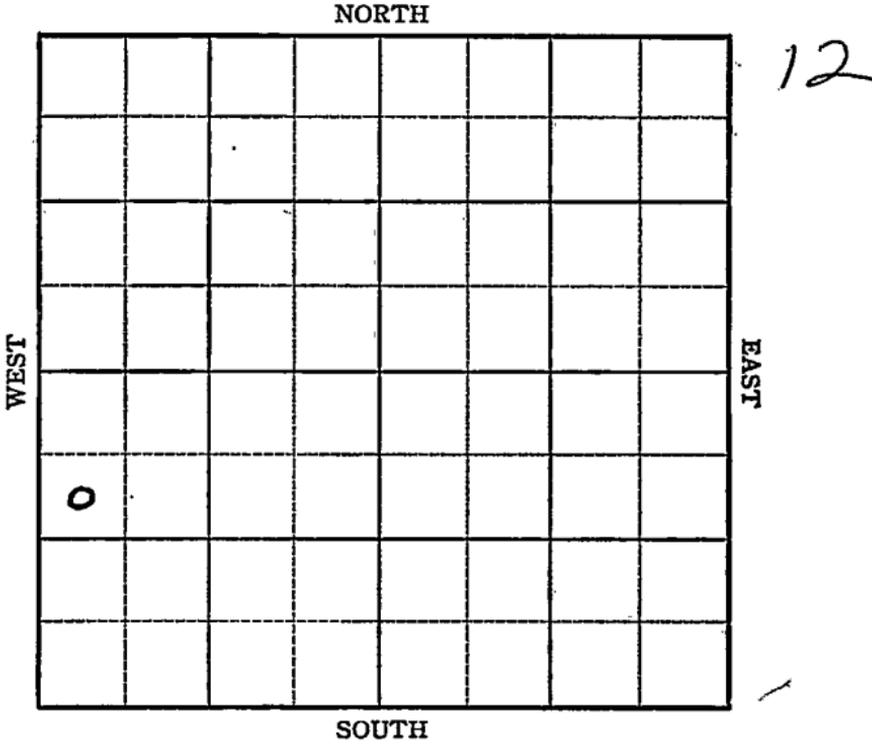

Harvey

KANSAS ✓

Sec. 8 Twp. 23 R. 3W

Well No. #3 Brown Farm

S. Lebow Company

Burrton Pool


990' Ft. from N. Line

_____ Ft. from S. Line

_____ Ft. from E. Line

330' Ft. from W. Line

SW NW SW

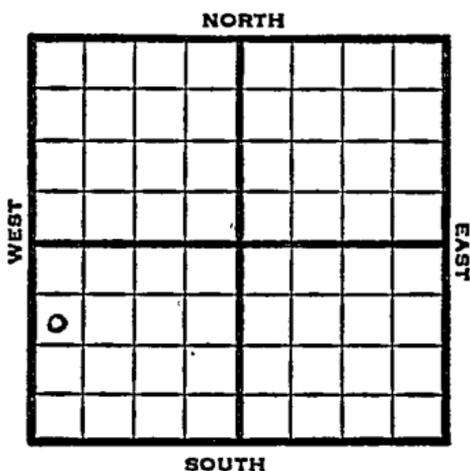

1949

Elev 1472' REPORT

8/17

8" @ 300'
Drlg. 1833'

8/24

Mississippi 3249-71 TD
5" @ 3249'

8/31

Miss 3277' (Corrected)
TD 3379'
1200' oil

9/7

3000 acid

9/14

TD 3379'
Miss 3277'
5" @ 3249'
3000 acid
Pump 60 Oil Pot
36° Gr.
Comp

COMPLETED

Kansas

Map No. _____ Sec. 8 Twp. 23 R. 3W

Well No. 3 Brown

S. Lebow Company

Contractor

SW NW SW

FIRST REPORT
SECTION PLAT

990 Ft. from N. Line

_____ Ft. from S. Line

_____ Ft. from E. Line

330 Ft. from W. Line

Harvey County

RECORD

Location _____

Cased _____ in. _____ ft.

Rig up _____

Sand _____

Drilling and Remarks:

Gas _____

8" @ 300

Oil _____

drlg. 1833

Total Depth _____

PRODUCTION

1st 24 hrs. Nat. _____

1st 24 hrs. after shot _____

Gas _____ Cu. Ft.

Dry Hole _____

Abandoned _____

Date

AUG 17 1949 19

S. J. LEWIS Scout

Map No. K39 Sec. 8 Twp. 23 R. 3W

Well No. 3 Brown

S. Lebow Company

COMPLETE

Contractor

SW NW SW

E11472
SECTION PLAT

990 Ft. from N. Line

_____ Ft. from S. Line

_____ Ft. from E. Line

330 Ft. from W. Line

Harvey County

Location _____

Rig up _____

Drilling and Remarks:

Min 3277
5" @ 32 78
3000 cu ft
Imp 6000 ft
36 5/8

RECORD

Cased _____ in., _____ ft.

Sand _____

Gas _____

Oil _____

Total Depth 3277

PRODUCTION

1st 24 hrs. Nat. _____

1st 24 hrs. after shot _____

Gas _____ Cu. Ft.

Dry Hole _____

Abandoned _____

Date

SEP 14 1949 19

S. J. LEWIS Scout