

WATSON

Harvey

Section 8 Township 23 Range 3W

Well No. 2 Brown


Company S. Lebow

Burrton

NORTH

WEST

EAST

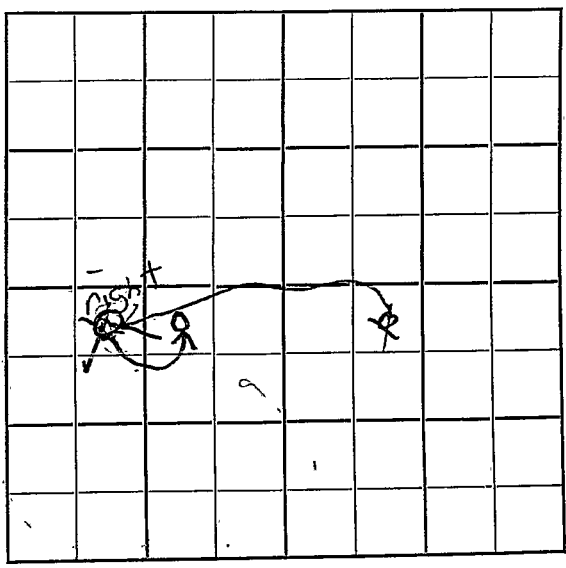

SOUTH

12

Harvey KANSAS ✓

Sec. 8 Twp. 23 R. 3W

Well No. #2 Brown Farm

S. Lebow Company


Burrton Pool

330' Ft. from N. Line

 Ft. from S. Line

~~990~~ Ft. from E. Line

~~330'~~
990 Ft. from W. Line

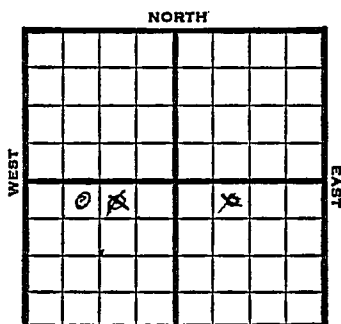

~~NE NW SE~~

~~NE NW SE~~ NE NW SW

1949 Elev 1477' REPORT

8/3 RUR
8/10 8" @ 330'
Drlg. 2915'
8/17 "
8/24 Mississippi 3265'
TD 3290
5" @ 3265'
8/31 4000 acid
9/7 Pump 25 bbls oil & 20 W
9/14 TD 3390'
Miss 3282'
5" @ 3265'
4000 acid
Pump 15 Oil / 20W Pot
36° Gr.
Comp

COMPLETED

Map No. _____ Sec. 8 _____ Twp. 23 _____ R. 3W _____

Well No. 2 Brown _____

S. Lebo ~~22~~ _____ Company _____

_____ Contractor _____

NE NW SE


FIRST REPORT
SECTION PLAT

330 Ft. from N. Line

_____ Ft. from S. Line

_____ Ft. from E. Line

990 Ft. from W. Line

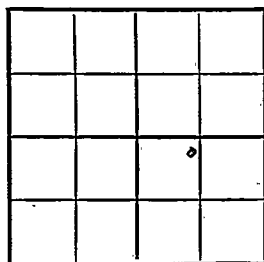

Harvey County

Location _____

Rig up _____

Drilling and Remarks:

R U R

RECORD

Cased _____ in., _____ ft.

Sand _____

Gas _____

Oil _____

Total Depth _____

PRODUCTION

1st 24 hrs. Nat. _____

1st 24 hrs. after shot _____

Gas _____ Cu. Ft.

Dry Hole _____

Abandoned _____

Date

AUG 3 1940 19

S. J. LEWIS Scout

Map No. _____ Sec. 8 Twp. 23 R. 3W

Well No. 2 Brown

S. Lebow

Company

CORRECTION

Contractor

NE NW SW

SECTION PLAT

o			

330 Ft. from N. Line

Ft. from S. Line

Ft. from E. Line

990 Ft. from W. Line

Harvey County

Location _____

Rig up _____

Drilling and Remarks:

Reported

NW NE SW

RECORD

Cased _____ in., _____ ft.

Sand _____

Gas _____

Oil _____

Total Depth _____

PRODUCTION

1st 24 hrs. Nat. _____

1st 24 hrs. after shot _____

Gas _____ Cu. Ft.

Dry Hole _____

Abandoned _____

Date

AUG 17 1949 19

S. J. LEWIS Scout

Kansas

Burton Pool

Map No. K39 Sec. 8 Twp. 23 R. 3WWell No. 2 Brown

S. Lebow

Company

CORRECTION

Contractor

NW NE SW

SECTION PLAT

	o		

330 Ft. from N. Line Ft. from S. Line990 Ft. from E. Line Ft. from W. Line

Harvey County

RECORDLocation Cased in., ft.Rig up Sand

Drilling and Remarks:

Gas Oil Total Depth

Reported

PRODUCTION

NE NW SE

1st 24 hrs. Nat. 1st 24 hrs. after shot Gas Cu. Ft.Dry Hole Abandoned

Date

AUG 10 1949 19S. J. LEWIS Scout

Kansas

Map No. K 39 Sec. 8 Twp. 23 R. 3WWell No. 2 Brown

S. Lebow Company

COMPLETE

Contractor

NE NW SW

E1.14??

SECTION PLAT

330 Ft. from N. Line

Ft. from S. Line

Ft. from E. Line

990 Ft. from W. Line

0			

Harvey County

Location

Rig up

Drilling and Remarks:

Miss 3282
5' @ 265
4000 acid
Pump Soil + 20W
BT

36° by

RECORD

Cased _____ in., _____ ft.

Sand _____

Gas _____

Oil _____

Total Depth 3282

PRODUCTION

1st 24 hrs. Nat. _____

1st 24 hrs. after shot _____

Gas _____ Cu. Ft.

Dry Hole _____

Abandoned _____

Date

SEP 14 1949

19

S. J. LEWIS

Scout