

Harvey

FORM 51 25M 3-49 PETROL

KANSAS

Section 8 Township 23 Range 3W

Well No. #3 Short

Company Simon Lebow

NORTH

0							

WEST EAST

SOUTH

4

KANSAS Harvey

Sec. 8 Twp. 23 R. 3-W

Well No. #3 Short Farm ☒

Simon Lebow Company

Simon Lebow Contractor


Burton
330 Ft. from N. Line

 Ft. from S. Line

 Ft. from E. Line

330 Ft. from W. Line

NW NW NW

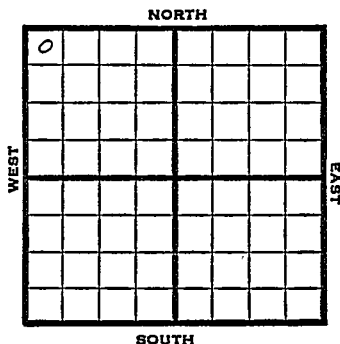

1950 Elev 1490' REPORT

10/18 Spud 10-12-50
8" @ 300
drlg 1600
11/15 8" @ 300
Miss 3291
5" @ 3352
TD 3385
FU 1600' oil 10 hr
S/20 bopd 3000 A
Comp 30 bopd
Completed
COMPLETED

County Harvey State KansasSec. 8 (Blk.) 23 (Sur.) 3W Map No.Operator Simon LebowWell No. 3 Farm ShortElev. Location 27 NW NW

0							

330 Ft. From N Line NW330 Ft. From W Line Quarter1st. Report OCT 11 & 1950

Completion

Remarks

Simon Lebow - Contr.Spudding Date 10-12-50Drlg. Data Burton Pool8" @ 300 clg. 1600

County Harvey State KansasSec. 8 (Blk.
Twp.) 23 (Sur.
Rge.) 3W Map No.Operator Simon LebowWell No. 3 Farm ShortElev. 1490 Location NW NW NW

0					

330 Ft. From N Line NW330 Ft. From W Line Quarter

1st. Report

Completion NOV 15 1950Remarks Burton PoolSimon Lebow - Contr.Spudding Date 10-12-50Drlg. Data Oil well TD 33858" @ 300 Miss. 3291 5" @ 3352 TD 3385FU 1600' oil 10 hr. - S/ 20 bopd 3000 AComp. 30 bopd