


Section 8 Township 23 Range 3-W

Well No. #4 Short

Company Simon & Lebow

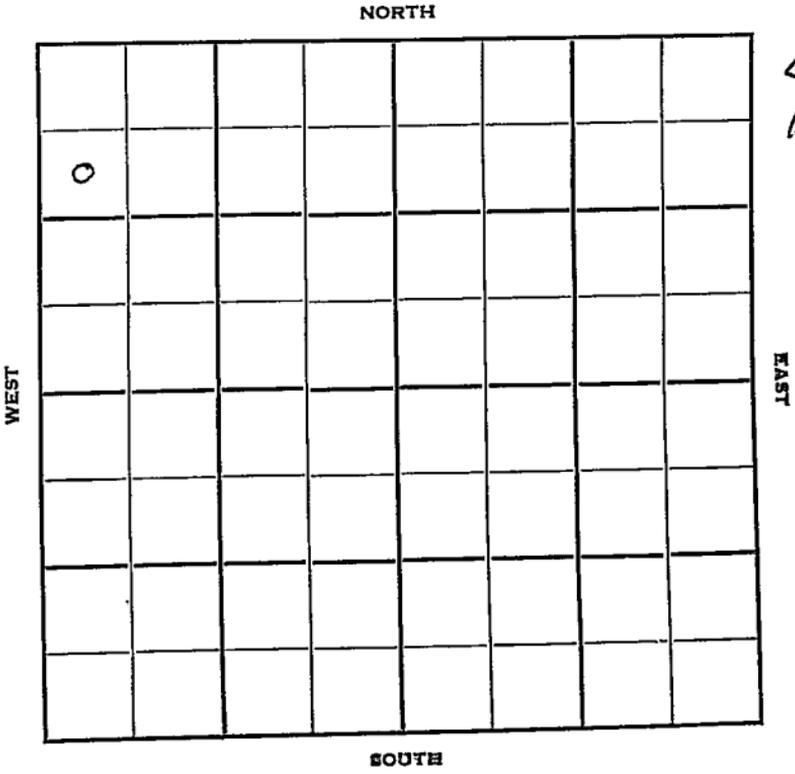

Harvey KANSAS

Sec. 8 Twp. 23 R. 3W

Well No. #4 Short Farm

Simon & Lebow Company

Lebow - Contr. Contractor


990' Ft. from N. Line

\_\_\_\_\_ Ft. from S. Line

\_\_\_\_\_ Ft. from E. Line

330' Ft. from W. Line

SW NW NW

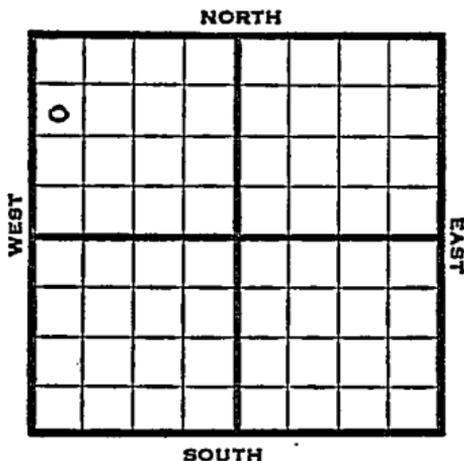

1950	? REPORT
10/25	RUR
11/22	Spud 10-24-50
	8 5/8" @ 310
	Miss 3291
	5" @ 3367
	TD 3388
	FU 900' oil 2500A
	Comp 50 bopd 50% water
	Completed
	<b>COMPLETED</b>

County Harvey State Kansas

Sec. 8 (Blk. 23) (Sur. 3W) (Twp.) (Rge.) Map No.

Operator Simon & Lebow

Well No. 4 Farm Short NW

Elev. Location SW NW NW

0					
<b>FIRST REPORT</b>					

990 Ft. From N Line NW

330 Ft. From W Line Quarter

Ist. Report OCT 25 1950

Completion \_\_\_\_\_

Remarks \_\_\_\_\_

Lebow - Contr.

Spudding Date \_\_\_\_\_

Drlg. Data

RUR

County Harvey State Kansas

Sec. 8 (Blk.) 23 (Sur.) 3W Map No.

Operator Simon & Lebow

Well No. 4 Farm Short

Elev. \_\_\_\_\_ Location SW NW NW


990 Ft. From N Line NW

330 Ft. From W Line Quarter

Ist. Report \_\_\_\_\_

Completion NOV 22 1950

Remarks Burrton Pool

Lebow - Contr.

Spudding Date 10-24-50

Drig. Data Oil well TD 3388

8 5/8" @ 310 Miss. 3291 5" @ 3367

TD 3388 FU 900' oil 2500 A

Comp. 50 bopd 50% water