


Section 8 Township 23 Range 3W

Well No. 6 Short

Company Simon Lebow

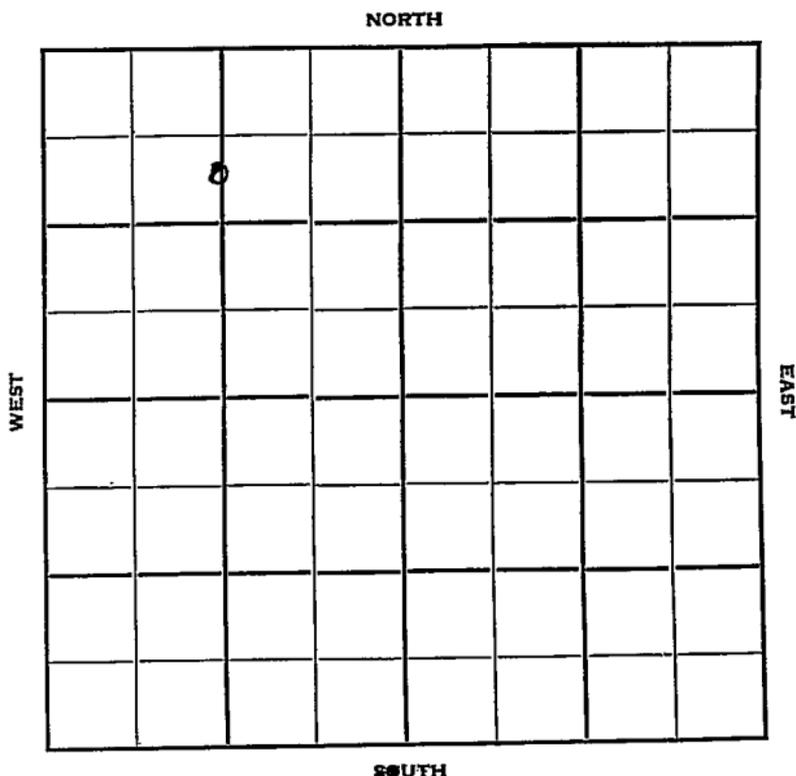

Sec. 8 Twp. 23 R. 3W ✓

Well No. #6 Short Farm

Simon Lebow Company

Penguin Drlg. - Contr. Contractor

Burrtn Pool


990' Ft. from N. Line

_____ Ft. from S. Line

_____ Ft. from E. Line

1320' Ft. from W. Line

C S L N $\frac{1}{2}$ NW

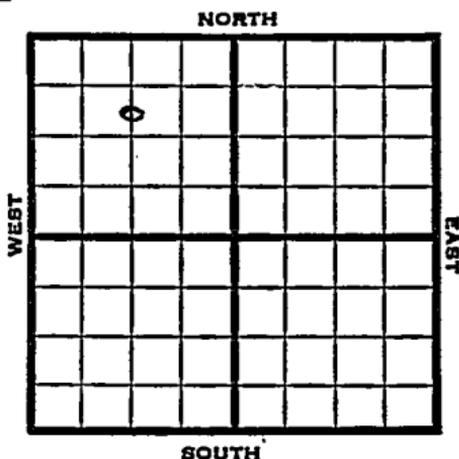

1951 Elev. 1485' REPORT

7/18 RUR

8/15 Spud 7-18-51
 Oil Well TD 3371
 8" @ 316
 Anhy 520 Miss 3285
 TD 3366 5" @ 3354
 DD 3371 FU 1000' fluid
 1000 A Comp. 25 bopd

COMPLETED

County Harvey State Kansas

Sec. 8 (Blk. 23) (Sur. Rge.) 3W Map No.

Operator Simon Lebow

Well No. 6 Farm Short

Elev. Location C S I. N $\frac{1}{2}$ NW

FIRST REPORT

990 Ft. From N Line NW

1320 Ft. From W Line Quarter

Ist. Report JUL 1 8 1951

Completion

Remarks

Penguin Drlg. - Contr.

Spudding Date

Drlg. Data Burrton Pool

RUR

