

# KANSAS


Harvey Co., Kansas  
Burrton Pool

Form 51-5M-7-39-Palace

Section 8 Township 23 Range 3W

Well No. #1 Fredrick

Company Drillers Gas

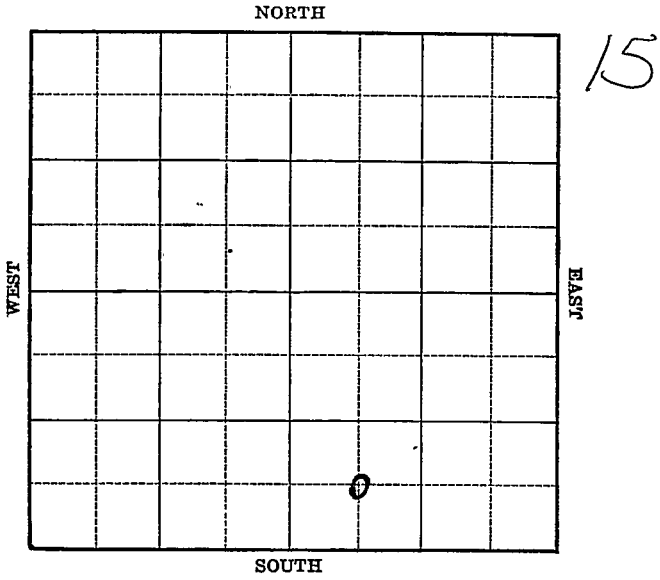



Map No. 39 Sec. 8 Twp. 23 R. 3WWell No. 1 FredrickDrillers Gas Company

Contractor

## FIRST REPORT

C SW SE

         Ft. from N. Line660 Ft. from S. Line         Ft. from E. Line660 Ft. from W. Line

BURRTON POOL

## SECTION PLAT

		o	

Location XRig up         

Drilling and Remarks:

## RECORD

Cased          in.;          ft.Sand         Gas         Oil         Total Depth         

## PRODUCTION

1st 24 hrs. Nat.         1st 24 hrs. after shot         Gas          Cu. Ft.Dry Hole         Abandoned         

Date

JUN 26 1940

19

S. J. LEWIS Scout

Map No. 39 Sec. 8 Twp. 23 R. 3WWell No. 1 Fredrick

Drillers Gas \_\_\_\_\_ Company

Contractor \_\_\_\_\_

**ABANDONED****SECTION PLAT****C SW SE**

\_\_\_\_\_ Ft. from N. Line

**660** Ft. from S. Line

\_\_\_\_\_ Ft. from E. Line

**660** Ft. from W. Line


**BURRTON POOL**

Location \_\_\_\_\_

Rig up \_\_\_\_\_

Drilling and Remarks:

*Miss 3272**5" @ 3279**1000 acid**HFW***RECORD**

Cased \_\_\_\_\_ in., \_\_\_\_\_ ft.

Sand \_\_\_\_\_

Gas \_\_\_\_\_

Oil \_\_\_\_\_

Total Depth. 3413**PRODUCTION**

1st 24 hrs. Nat. \_\_\_\_\_

1st 24 hrs. after shot \_\_\_\_\_

Gas \_\_\_\_\_ Cu. Ft.

Dry Hole \_\_\_\_\_

Abandoned \_\_\_\_\_

Date

III 24 1940S. J. LEWIS Scout