

Reno

KANSAS

Section 8 Township 23 Range 4WWell No. 1 FredrickCompany Virginia Drlg.

0							

NORTH

WEST

EAST

SOUTH

Reno

KANSAS ✓

Sec. 8 Twp. 23 R. 11W

Well No. #1 Fredrick Farm

Virginia Drlg. _____ Company

Virginia Drlg. Contractor

Wildcat

Ft. from N. Line


330 Ft. from S. Line

Ft. from E. Line

330 Ft. from W. Line

SW SW SW

Sinclair - DHM

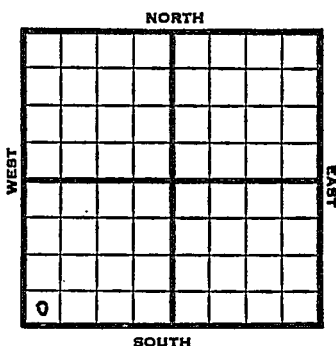

1953	Elev. 1586'	REPORT
------	-------------	--------

1/14 Spud 1-6-53
8" @ 717
Drlg. 1800

1/22	Lans 2760, Miss 3465 Drlg. 3527'
------	-------------------------------------

1/28 Spud 1-6-53 D & A TD 4120'
8" @ 717 Br. lime 2751'
Lans. 2772' Miss. 3465' Kh. 3690',
Misener 3854', Hunton 3858',
Maq. 3909', Viola 3974', Simp. 3994'
Arb. 4086'
TD 4120' D & A

ABANDONED

County Reno State Kansas
Sec. 8 (Blk. 23 (Sur. 4 Map No. 17)
(Twp.) (Rge.)

Sec. 8 (Blk.) 23 (Sur.) 47 Map No.

Operator Virginia Drlg.

Well No. **1** Farm **Fredrick**

Elev.	Location	SW	SW	SW
-------	----------	----	----	----

330 Ft. From S Line SW

330 Ft. From ~~W~~ Line Quarter

1st. Report JAN 14 1952

Completion

Remarks Sinclair - FBI

Virginia Drlg. - Contr.


Spudding Date **1-6-53**

Drlg. Data Wildcat

8" @ 717 drlg. 1800

J. G. McGEHEE

County Reno State Kansas
 Sec. 8 (Blk.) 23 (Sur.) 4W Map No.
 Operator Virginia Drlg.
 Well No. 1 Farm Fredrick
 Elev. 1586 Location SW SW SW

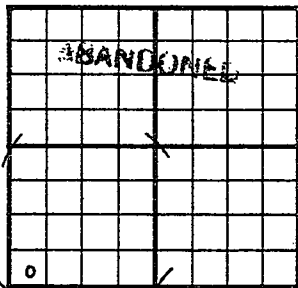

330 Ft. From S Line SW
330 Ft. From W Line Quarter
 1st. Report
 Completion JAN 28 1953
 Remarks Wildcat
Virginia Drlg. - Contr.
 Spudding Date 1-6-53

Drlg. Data D & A TD 4120

8" @ 717 Brs lime 2751 Lans. 2772

Miss. 3465 Kh. 3690 Misener 3854

Hunton 3858 Mag. 3909 Viola 3974

Simp. 3994 Arb. 4086 TD 4120

D & A