



Sec. 8 Twp. 23 R. 16W

Well No. #1 Schartz Farm

Tom-O-Hawk Petr. Company


Iron Drlg. Contractor  
Wildcat

330 Ft. from N. Line

Ft. from S. Line

Ft. from E. Line

330 Ft. from W. Line

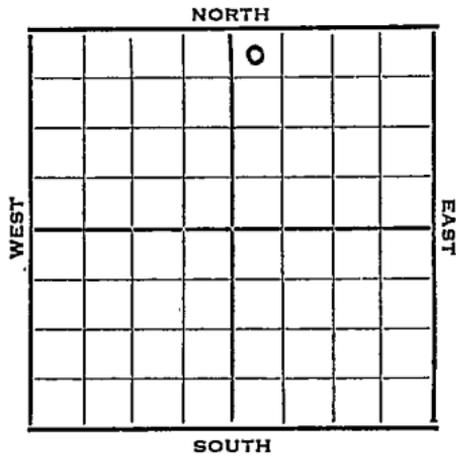

NW NW NE  
Magnolia - DHM

1953 Elev. 2061' REPORT

2/25 Spud 2-15-53  
8" @ 150  
Heeb 3509  
Drlg. 3570

3/4 Spud 2-15-53  
D&A  
TD ~~4300~~ 4299'  
8" @ 150  
Heeb 3509, Br lime 3622, Lans 3631, Cong 4034, ReSimp 4160, Arb 4236  
DST 4231-41, opn 1 hr., rec. 10' mud  
TD ~~4300~~ 4299'  
D&A

4/29 CORRECTED SCHLUMBERGER TOPS:  
Heeb 3593' Br lime 3712', Lans 3721'  
Viola 4089', Simp. 4140', Arb. 4210'  
TD 4299'

**ABANDONED**

**ABANDONED**

County Pawnee State Kansas

Sec. 8 (Blk. 23) (Sur. 16W) (Twp. 16W) Map No.

Operator Tom-O-Hawk Pet.

Well No. 1 Farm Schartz

Elev. \_\_\_\_\_ Location NW NW NE


330 Ft. From N Line NE

330 Ft. From W Line Quarter

1st. Report FEB 25 1953

Completion \_\_\_\_\_

Remarks Magnolia - IHM

Iron Drlg. - Contr.

Spudding Date 2-15-53

FIRST REPORT

Drlg. Data Wildcat

8" @ 150 Heeb. 3509 drlg. 3570

Map No. \_\_\_\_\_ Sec. 8 Twp. 23 R. 16W

Well No. 1 Schartz

Tom-O-Hawk Pet. \_\_\_\_\_ Company

**CORRECTION**

Contractor

NW NW NE

SECTION PLAT

330 Ft. from N. Line

\_\_\_\_\_ Ft. from S. Line

\_\_\_\_\_ Ft. from E. Line

330 Ft. from W. Line

		0	

Pawnee County

Comp. 4-4-53

Location \_\_\_\_\_

Rig up \_\_\_\_\_

~~REGORD~~

Cased \_\_\_\_\_ in., \_\_\_\_\_ ft.

Sand \_\_\_\_\_

Gas \_\_\_\_\_

Oil \_\_\_\_\_

Total Depth \_\_\_\_\_

\_\_\_\_\_

PRODUCTION

1st 24 hrs. Nat. \_\_\_\_\_

1st 24 hrs. after shot \_\_\_\_\_

Gas \_\_\_\_\_ Cu. Ft.

Dry Hole \_\_\_\_\_

Abandoned \_\_\_\_\_

Drilling and Remarks:

SCHLUMBERGER TOPS

Heeb. 3593

Br. line 3712

Lans. 3721

Viola 4089

Simp. 4140

Arb. 4210

TD 4299

Date

APR 20 1959

J. G. McGEHEE

Scout

County Pawnee State Kansas

Sec. 8 (Blk. Twp.) 23 (Sur. Rge.) 16W Map No.

Operator Tom-O-Hawk Pet.

Well No. 1 Farm Schartz

Elev. 2061 Location NW NW NE


330 Ft. From N Line NE  
330 Ft. From W Line Quarter

1st. Report

Completion MAR 4 1953

Remarks Wildcat

Iron Drlg. - Contr.

Spudding Date 2-15-53

Drlg. Data D & A TD 4300

8" @ 150 Heeb. 3509 Br. lime 3622

Lans. 3631 Cong. 4034 Re&imp. 4160

Arb. 4236 DST 4231-41 open 1 hr.

Rec. 10' mud TD 4300

D & A