


Section 8 Township 23 Range 16W

Well No. #1 Schartz

Company Murfin Drlg.

NORTH

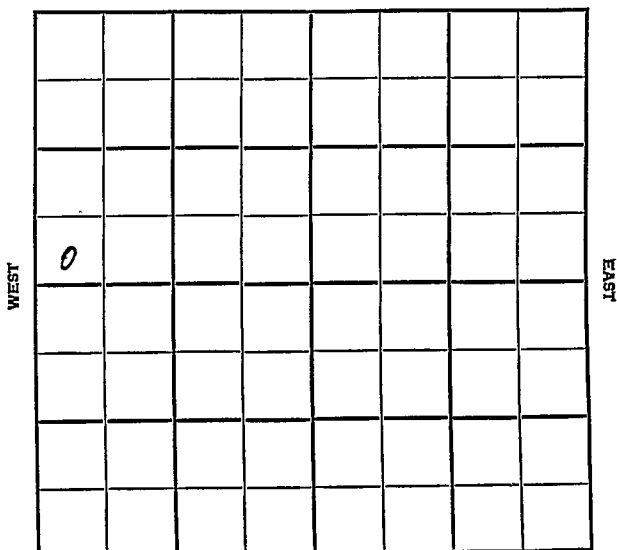

SOUTH

Pawnee KANSAS

SEC.	TWP.	R.
8	23	16W

WELL NO. _____

COMPANY 1 S chartz FARM

CONTRACTOR Murfin Drlg.

Co. Tools


Wildcat

_____ Ft. from N. Line

330 _____ Ft. from S. Line

_____ Ft. from E. Line

330 _____ Ft. from W. Line

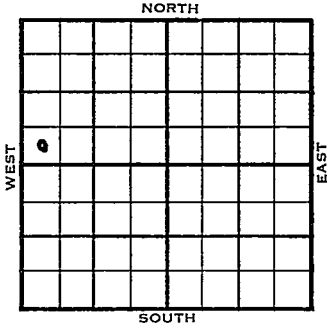

SW SW NW

Sunray - Support

	ELEVATION	REPORT
1955	2062'	

3/23 Spud 3-20-55
8" @ 232'
Anhy 1065'
Drlg. 1555'

4/6 Spud 3-20-55, D&A-TD 4410
8" @ 232, Anhy 1065, Heeb 3593
Br Lime 3712, KC 3724, Cong
4127 Simp 4317, Arb 4376,
TD 4410, DST 4126-40 open 1 hr
Rec 658 mud 1250#, DST 4140-62,
open 1-hr Rec 75' GCM 60' MW
1260#
D&A

ABANDONED

County Pawnee State Kansas

Sec. 8 (Blk. 23) (Sur. Rge.) 16W Map No.

Operator Murfin Drlg.

Well No. 1 Farm Schartz

Elev. 2062 Location SW SW NW

330 Ft. From S Line NW

330 Ft. From W Line Quarter

Ist. Report

Completion APR 6 1955

Remarks Wildcat

Co. tools

Spudding Date 3-20-55

Drlg. Data D & A TD 4410

8" @ 232 Anhy 1065 Heeb. 3593

Br. lime 3712 KC 3724 Cong. 4127

Simp. 4317 Arb. 4376 TD 4410

DST 4126-40 open 1 hr. Rec. 65' mud

1250# DST 4140-62 open 1 hr. Rec.

75' gcm 60' mw 1260#

D & A

FABEN GILSTRAP