


Section 8 Township 23 Range 17W

Well No. #1 Scharitz

Company Hilton Drlg.

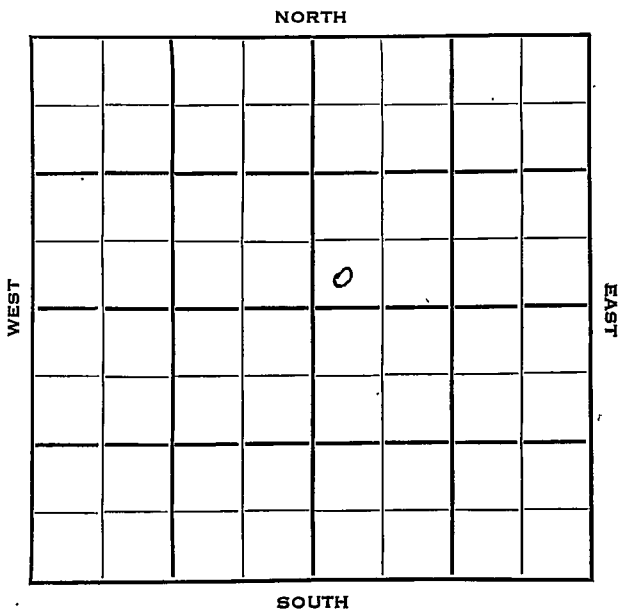


Pawnee

SEC.	TWP.	R.
8	23	17W ✓

WELL NO. _____
 COMPANY #1 Scharitz FARM

CONTRACTOR Hilton Drlg.

Hilton Drlg.
 Garfield Pool

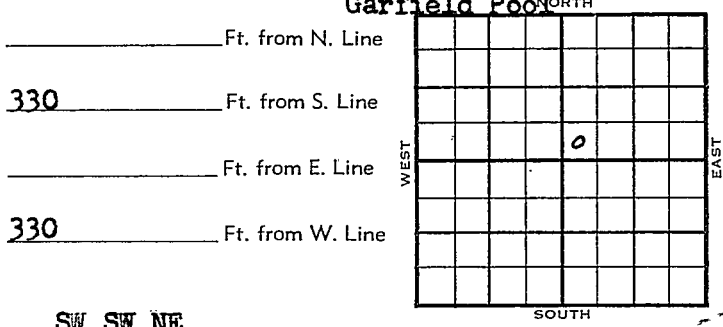

SW SW NE

	ELEVATION	REPORT
1954	2076'	
4/27		Location
5/5		8" @ 213' w/200 sks Drlg 2620'
5/12		Heeb 3628', Br. L. 3731', Lans 3738' Drlg 4029'
5/19		B KC 4101' Cong 4164', Miss 4204' DST 4186'-4230' 1 hr, HFO, 1290# Misner 4256' DST 4270'-84' 1 hr, 150' SOCM, 150# V 4291' RTD 4350' 5" @ 4349'
6/2		Spud 4-28-54 Oil well TD 4350 8" @ 213' Heeb 3628' Br. lime 3731 Lans. 3738 B KC 4101 Cong 4164 Ch. Cong. 4190' Miss. 4204' DST 4186-4230 open 1 hr gas in 10 min HFO in 4 min. 1290# Meisner 4256' DST 4270-84 open 1 hr rec 150' SOCM 150# Viola 4291 TD 4350 5" @ 4349 GO to 4255 72/4205-19 sd-oil-frac. 250 M-acid. F/45 BOPH Comp. 3000 BOPD

COMPLETED

