


Section 8 Township 23 Range 17W

Well No. 1 Clark

Company Welch & Olsson Drlg.

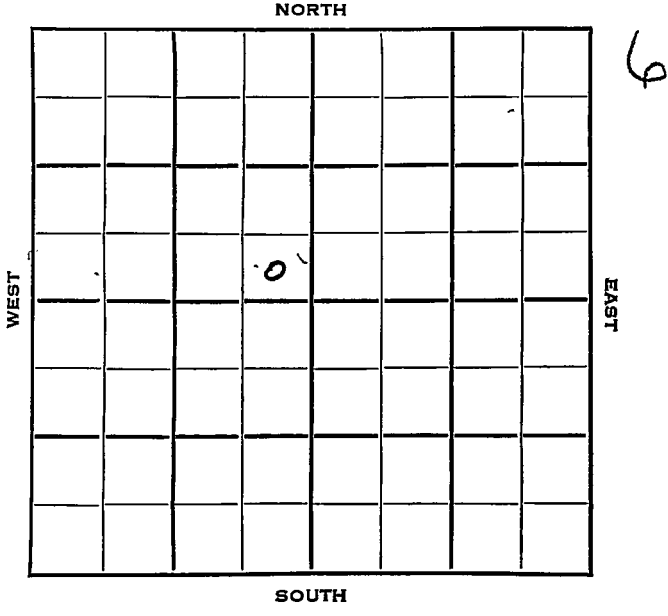

SEC.	TWP.	R.
8	23	17W ✓

WELL NO.

#1 Clark

FARM

COMPANY

Welch & Olsson Drlg.

CONTRACTOR

Co. Tools.

Semi-Wildcat.


NORTH

_____ Ft. from N. Line

330 _____ Ft. from S. Line

330 _____ Ft. from E. Line

_____ Ft. from W. Line

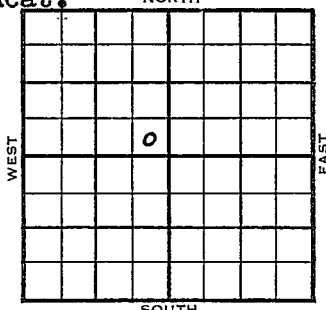

SE SE NW

	ELEVATION	REPORT
1954	2074'	
3/10	Spud 3-8-54 8" @ 304' Drlg 1380'	
3/17	Anhy 1102', Heeb 3627', Br. L. 3733' Lans 3740' Drlg 3900'	
3/24	Cong 4167', Miss 4205' DST 4207'-25' 1 hr, 740' clean oil 210' mco, 30' ocm, 1425# DST 4225'-45' 1 hr, 35' M DST 4265'-85' 1 hr, 90' ocm, 115# V 4305' Drlg 4412'	
3/31	DST 4320'-40' 1 hr, 60' ocm, 520# Simp 4439', Arb 4482' RTD 4500' 5" @ 4500'	
4/7	C0 4490' 84/ 4212-26 S/ 3½ BOPH 12 hrs. sd-o-frac. F 3½ BOPH 3 hrs.	
4/21	Spud 4-8-54 Oil Well TD 4500' 8" @ 304' Anhy 1102', Heeb 3627', Br. Lime 3733'	


1954

Information brought forward.

4/21


Lans 3740', Cong 4167', Miss 4205'
DST 4207'-25' opn 1 hr, rec 740' clean
oil, 210' mco, 30' ocm 1425#
DST 4225'-45' opn 1 hr, rec 35'
mud 0#
DST 4265'-85' opn 1 hr, rec 90' ocm.
115# Viola 4305'
DST 4320'-40' opn 1 hr, rec 60' ocm
520# Simp 4439', Arb 4482'
TD 4500'
5" @ 4500'
CO to 4490'
84/ 4212-26
S/ $3\frac{1}{2}$ boph 12 hr. sd-oil-frac
F/ $53\frac{1}{2}$ boph 3 hr.
Comp 3000 bopd.

COMPLETED

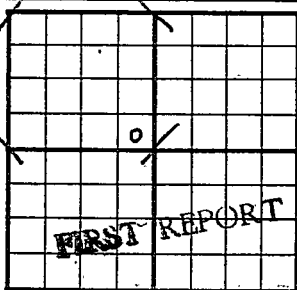County Pawnee State KansasSec. 8 (Blk. 23 (Sur. 17W Map No.)
(Twp.) (Rge.)Operator Welch & Olsson Drlg.Well No. 1 Farm ClarkElev. Location SE SE NW330 Ft. From S Line NW330 Ft. From E Line Quarter1st. Report MAR 10 1954Completion Remarks Co. toolsSpudding Date 3-8-54Drlg. Data Semi Wildcat8" @ 304 drlg. 1380

J. G. McGEHEE

County Pawnee State Kansas
 Sec. 8 (Blk.) 23 (Sur.) 17W Map No.
 Operator Welch & Olsson Drlg.
 Well No. 1 Farm Clark
 Elev. 2074 Location SE SE NW

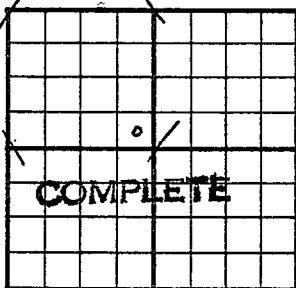

330 Ft. From S Line NW
330 Ft. From E Line Quarter
 Ist. Report
 Completion APR 21 1954
 Remarks Semi Wildcat
Co. tools.
 Spudding Date 3-8-54

Drlg. Data Oil well TD 4500
8" @ 304 Anhy 1102 Heeb. 3627
Br. lime 3733 Lans. 3740 Cong. 4167
Miss. 4205 DST 4207-25 open 1 hr.
Rec. 740' clean oil 210' mco 30' ocm
1425# DST 4225-45 open 1 hr. Rec. 35'
mud 0# DST 4265-85 open 1 hr. Rec.
90' ocm 415# Viola 4305 DST 4320-40
open 1 hr. Rec. 60' ocm 520#
Simp. 4439 Arb. 4482 TD 4500
5" @ 4500 CO to 4490 84/ 4212-26
S/ 3 1/2 boph 12 hr. sd-oil-frac
F/ 5 3 1/2 boph 3 hr. Comp. 3000 bopd

J. G. McGEHEE