


DX 78-1

Pawnee Kansas

Section 8 Township 23 Range 17W

Well No. 2 Clark

Company Welch & Olsen

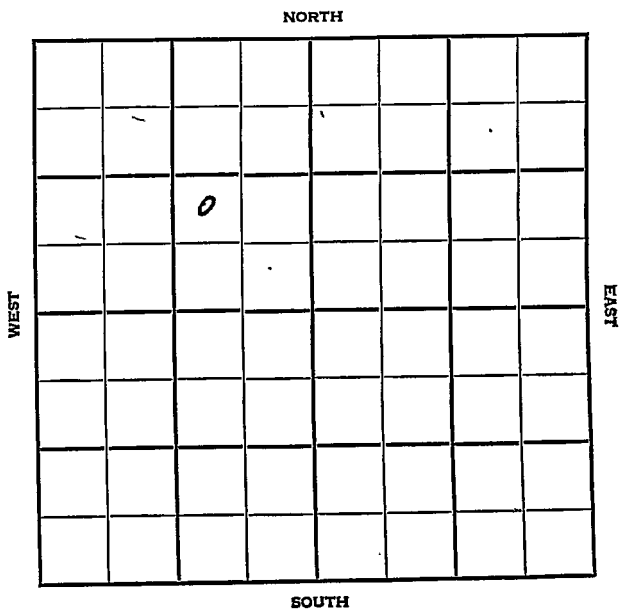

SEC.	TWP.	R.
8	23	17 W ✓
WELL NO.		
# 2 Clark		
COMPANY		FARM
Welch & Olsson		
CONTRACTOR		

Garfield Pool


Ft. from N. Line

990 Ft. from S. Line

990 Ft. from E. Line

_____ Ft. from W. Line

NW SE NW

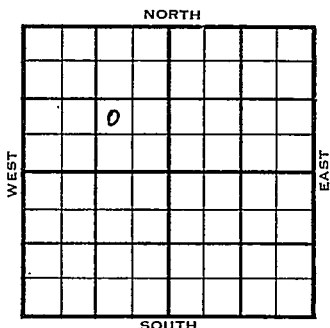

	ELEVATION	REPORT
1954	2071'	
5/26	Spud 5-22-54 8" @ 265'	
	Drlg. 2000'	
6/2	Drlg. 3000'	
6/9	Heeb 3625'; Br li 3730', Lans 3738', Cong 4161', Miss 4198'	
6/23	V 4284 RTD 4325 5" @ 4324 CO 4313'	
6/30	N. R.	
7/7	Spud 5-22-54 Oil well TD 4325 8" @ 265' Heeb 3625 Br. lime 3730 Lans. 3738 Cong. 4161 Miss 4198 Viola 4284 TD 4325 5" @ 4324 CO to 4313 Meisner 4242 48/4200-12 F/40 BOPH Comp. 316 BOPD	

COMPLETED

County **Pawnee** State **Kansas**
 Sec. **8** (Blk. Twp.) **23** (Sur. Rge.) **17W** Map No.
 Operator **Welch & Olsson**
 Well No. **2** Farm **Clark**
 Elev. Location **NW SE NW**

		0					

990 Ft. From **S** Line **NW**
 990 Ft. From **E** Line Quarter

1st. Report

MAY 26 1954

Completion

Remarks


Spudding Date **5-22-54**

Drlg. Data

Garfield Pool

8" @ 265 drlg. 2000

J. G. McGEHEE

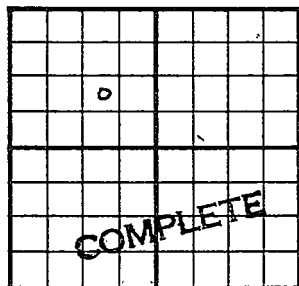County Pawnee State KansasSec. 8 (Blk. 23) (Sur. Rge.) 17W Map No. _____Operator Welch & OlssonWell No. 2 Farm ClarkElev. 2071 Location NW SE NW990 Ft. From S Line NW990 Ft. From E Line Quarter

1st. Report _____

Completion JUL 7 1954Remarks Garfield PoolSpudding Date 5-22-54Drilg. Data Oil well TD 43258" @ 265 Heeb. 3625 Br. line 3730Lans. 3738 Cong. .4161 Miss. 4198Viola 4284 TD 4325 5" @ 4324CO to 4313 Meisner 4242 48/ 4200-12F/ 40 boph Comp. 316 bopd

J. G. McGEHEE