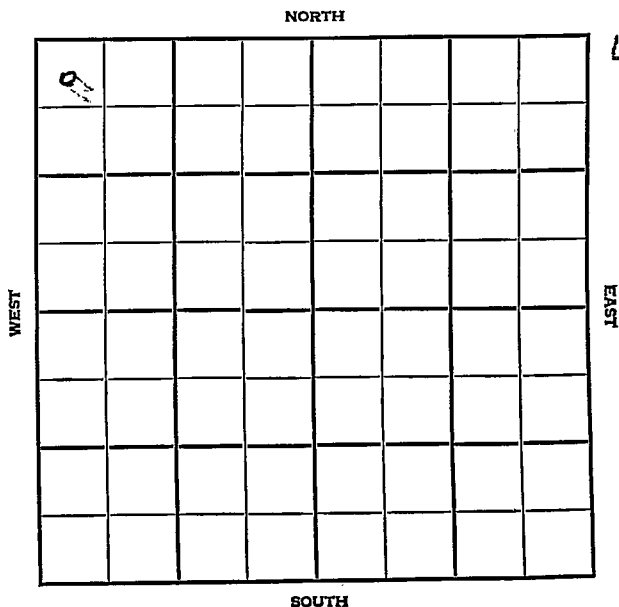


Section 8 Township 223 Range 17WWell No. 3 ClarkCompany Welch & Olsson

KANSAS

SEC.	TWP.	R.
8	23	17W ✓

WELL NO.

3 Clark

FARM

COMPANY

Welch & Olsson

CONTRACTOR

Co. tools

Garfield Pool

330 Ft. from N. Line


Ft. from S. Line

Ft. from E. Line

330 Ft. from W. Line

NW NW NW

NORTH

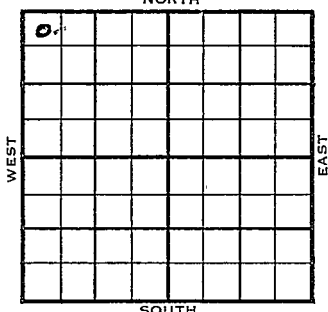

SOUTH

1954

ELEVATION

2065¹

REPORT

6/9

Spudding 6-4-54

811 @ 232

Anhy 1108

Dr1g. 2275

6/23

Heeb 3621 Br li 3723 Lans 3732

Cong 4157 Cherty Cong 4174

Miss 4192

DST 4185-4213, 1 hr, 30' GCM 0#

V 4279 RTD 4310 5" Set.

6/30

5" Set 4308

7/21

Spud 6-4-54 Oil well TD 4310

8" @ 232 Any 1108 Heeb 3621

Br. lime 3723 Lans 3732

Cong. 4157 Ch. Cong. 4174

Miss 4192

DST 4185-4213 open 1 hr rec 30' GCM 0#

Viola 4279 TD 4310 5" @ 4308

Meisner 4231 32/4232-40 frac.

F/15 BOPH Comp. F/301 BOPD

COMPLETED

County Pawnee State KansasSec. 8 (Blk. Twp.) 23 (Sur. Rge.) 17W Map No.Operator Welch & OlssonWell No. 3 Farm ClarkElev. Location NW NW NW

0							

330 Ft. From N Line NW330 Ft. From W Line Quarter1st. Report JUN 9 1954

Completion

Remarks

Co. toolsSpudding Date 6-4-54Drlg. Data Garfield Pool8" @ 232 Anhy 1108 drlg. 2275

J. G. McGEHEE

County Pawnee State Kansas
 Sec. 8 (Blk.) 23 (Sur.) 17W Map No.
 Operator Welch & Olsson
 Well No. 3 Farm Clark
 Elev. 2065 Location NW NW NW

0						

330 Ft. From N Line NW
330 Ft. From W Line Quarter
 Ist. Report JUL 21 1954
 Completion
 Remarks Garfield Pool
Co. tools
 Spudding Date 6-4-54

Drlg. Data Oil well TD 4310
8" @ 232 Anhy 1108 Heeb. 3621
Br. lime 3723 Lans. 3732 Cong. 4157
Ch. Cong. 4174 Miss. 4192 DS T 4185-4213
open 1 hr. Rec. 30' gcm 0#
Viola 4279 TD 4310 5" @ 4308
Meisner 4231 32/ 4232-40 frac
F/ 15 boph Comp. F/ 301 bopd