

Section 8 Township 23 Range 17W

Well No. 4 Clark

Company Welch & Olsson

NORTH

WEST

EAST

SOUTH

			0				

3

Pawnee

KANSAS

SEC.	TWP.	R.
8	23	17 W
WELL NO.		
# 4 Clark		FARM
COMPANY		
CONTRACTOR Welch & Olsson		

Co. tools


330 Ft. from N. Line

Ft. from S. Line

330 Ft. from E. Line

Ft. from W. Line

NE NE NW

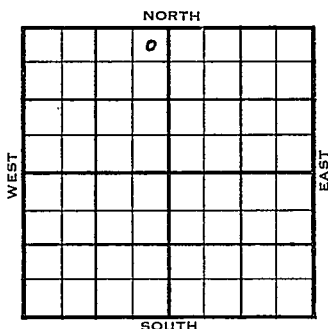

	ELEVATION	REPORT
1954	2066'	

7/14 Location

7/21 8" @ 232'
Drlg. 2900'

9/15 Spud 7-15-54 - Oil Well

TD ~~XX~~ 4310'

8" @ 232'

Heeb 3615', Br lime 3719', L ans
3727', Cong 4147', Miss 4184'

D T 4186-4210', opn 1 hr., rec.

950' gco, 1440#

Meisner 4228', Viola 4264'

TD 4310'

5" @ 4310'

CO to 4250'

36/4234-40

Sd-oil-frac

S/2 boph 8 hrs.

PB 4228'

30/4221-27,

Sd-oil-frac

F/150 boph 12 hrs.

Comp. F/444 bopd

COMPLETED

County Pawnee State KansasSec. 8 (Blk.) 23 (Sur.) 17W Map No.Operator Welch & OlssonWell No. 4 Farm ClarkElev. Location NE NE NW

			0			

330 Ft. From N Line NW330 Ft. From E Line Quarter1st. Report JUL 14 1954

Completion

Remarks

Co. tools

Spudding Date

Drilg. Data

Location

J. G. MCGHEE

FABEN GILSTRAP