


Pawnee KANSAS

DX 78-1

Section 8 Township 23 Range 17W

Well No. 5 Clark

Company Welch & Olsson

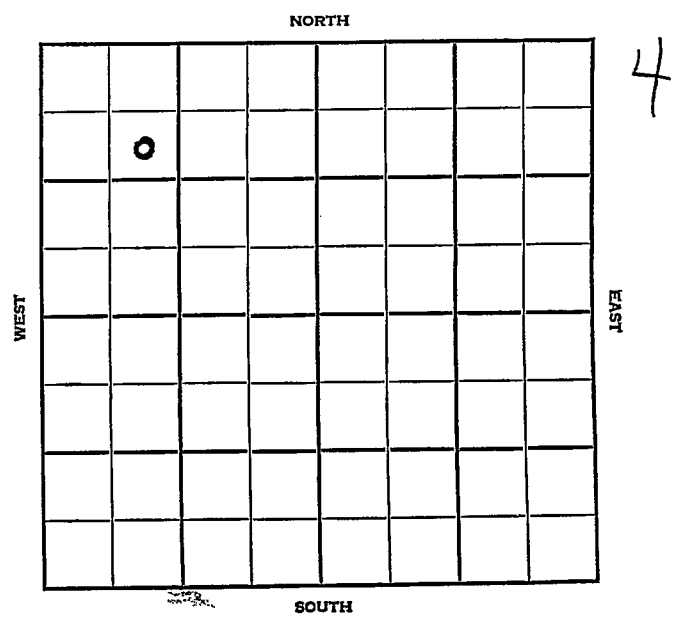

Pawnee KANSAS


SEC.	8	TWP.	23	R.	17W
------	---	------	----	----	-----

WELL NO. 5 Clark FARM

COMPANY Welch & Olsson

CONTRACTOR Co. tools
Garfield Pool

990 _____ Ft. from N. Line
 _____ Ft. from S. Line
 _____ Ft. from E. Line
 990 _____ Ft. from W. Line

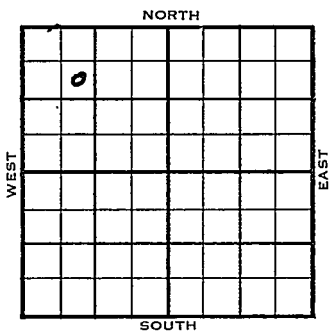

SE NW NW

1954	ELEVATION	REPORT
	2066'	

7/28 Location

10/6 Spud 7-28-54 Oil well TD 4320'
 8" @ 229 Heeb 3624 Br line 3727
 KG 3735' Cong. 4164 Miss 4198
 DST 4200-25, open 1 hr, rec 50' SO & X
 GCM 200# Misener 4250' Viola 4209
 TD 4320 5" @ 4319 GO to 4320
 Perf /4234-43 4206-08 4214-24
 sd-frac S/4 BOPH Comp. 197 BOPD

COMPLETED

County Pawnee State Kansas

Sec. 8 (Blk. 23) (Sur. 17W) (Twp. Rge.) Map No.

Operator Welch & Olsson

Well No. 5 Farm Clark

Elev. 2066 Location SE NW WW

990Ft. From N Line NW

990Ft. From W Line Quarter

1st. Report

Completion OCT 6 1954

Remarks Garfield Pool

Co. tools

Spudding Date 7-28-54

Drlg. Data Oil well TD 4320

8" @ 229 Heeb. 3624 Br. lime 3727

KC 3735 Cong. 4164 Miss. 4198

DST 4200-25 open 1 hr. Rec. 50' so & gcm

200# Misener 4250 Viola 4209

TD 4320 5" @ 4319 CO to 4320

perf/ 4234-43 4206-08 4214-24

sd-frac S/ 4 boph Comp. 197 bopd

FABEN GILSTRAP