


Section 8 Township 23 Range 17 W

Well No. # 8 L. J. Shartz

Company Hilton Drlg.

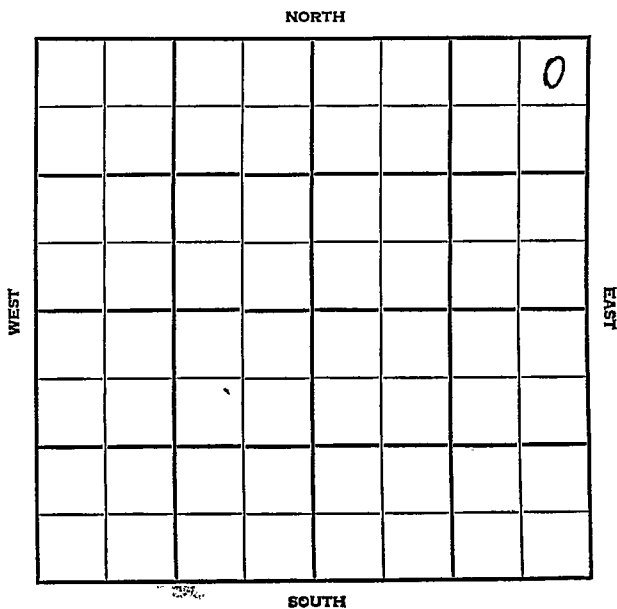

Pawnee KANSAS


SEC.	TWP.	R.
8	23	17W

WELL NO. 8 L. J. Shartz FARM

COMPANY Hilton Drlg.

CONTRACTOR Co. Tools

Garfield Pool
 330 Ft. from N. Line
 _____ Ft. from S. Line
 330 Ft. from E. Line
 _____ Ft. from W. Line

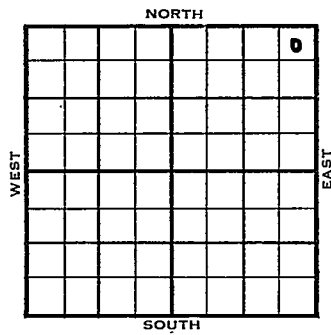

NE NE NE

1955	ELEVATION	REPORT
	2067'	

2/16 Spud 2-11-55
 8" @ 220'
 Drlg. 1755'

3/23 Spud 2-11-55, Oil Well, TD 4264
 8" @ 220, Heeb 3620, Br Line
 3718, Lans 3726, Cong 4170,
 DST 4150-84, open 45 min. gas
 in 1 1/2 min. 10,000,000 CFG,
 1 GO 2' mud, 1285#, DST 4170-84
 open 45 min. gas in 1 min.
 10,000,000 CFG, 110' oil, 1245#
 Miss 4191, DST 4191-4208
 open 1 hr 15 min, gas in 3 min
 oil in 7 min; 1270#, Misener
 4216, Viola 4251, TD 4264,
 5" @ 4253, 32/4184-90, frac
 F/21 BOPM. Comp BHP 3000 BOPM

COMPLETED

