


Section 8 Township 23 S Range 17 WWell No. #9 L. J. SchartzCompany Hilton Drlg. Co., et al

NORTH

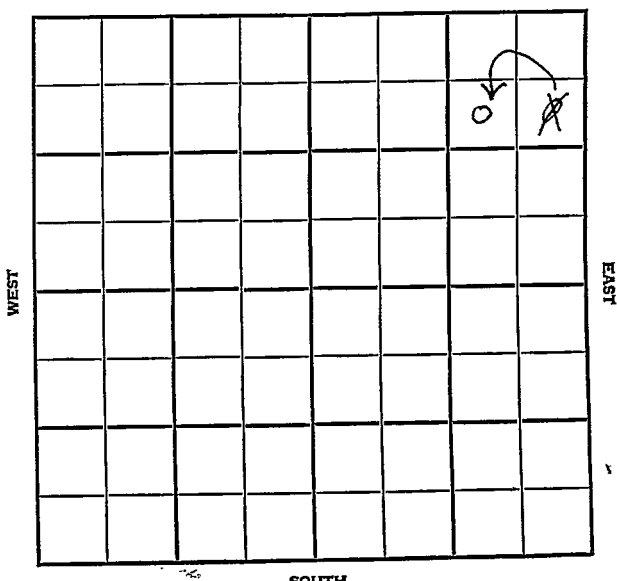

Pawnee

KANSAS

SEC.	8	TWP.	23S	R.	17W
------	---	------	-----	----	-----

WELL NO.

#9 L. J. Schartz

FARM

COMPANY

Hilton Drlg Co et al

CONTRACTOR

Co. Tools


Garfield

990 Ft. from N. Line

Ft. from S. Line

990 Ft. from E. Line

Ft. from W. Line

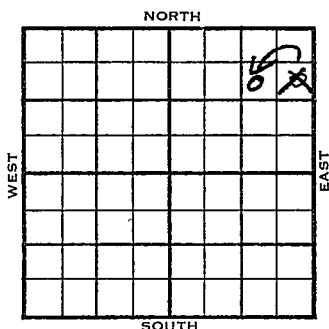SW
SE NE NE

	ELEVATION	REPORT
1955	2082'	

9/28 RURT

11-23 Comm. 9-26-55
 8 5/8" @ 248/195
 DST 4186-98 op 1 1/2 hr., gas in 45 min.
 rec. 60' gcm, 1100/30"
 DST 4198-4214 gas to surface in 4 min.
 open 35 min. oil to surface in 26 min.
 1163/30"
 5 1/2" @ 4281/400
 C0 48/4200-08, frac
 S & F/ 15 bo 12 hrs.,
 S & F/ 13 BOPH
 Comp. 323 BOPH
 H. 3627
 B.L. 3733
 L. 3741
 Shly 4156
 Cg. Sd. 4167
 Cg. Chert 4187
 M Cht 4198
 Sd 4239
 S. 4268
 TD 4283'

COMPLETED

County Pawnee Elev. _____
 Sec. 8 Twp. 23S Rge. 17W
 Company Hilton Drig. Co., etal
 Farm Name L. J. Schartz No. 9

TOPS	DEPTH	LOG	DATUM	Loc. in Sec.
Anh.				SE NE NE
Tp.				
H.				
Tr.				
Dg.				
Bl.				
L.				Geol.
K.C.				Contr.
B.K.C.				Co. tools
Ce.				rig #2
C.				Pool
M.				Garfield
M.				
V.				
S.				
S.				
A.				
R.				
Pf.				FIRST REPORT
G.				
T.D.				

Date Comm. SEP 28 1955
RURT

Co.

Use.

No.

Sec.

T.

R.

SCOUT TICKET

DX-201

SEC.

TWP.

R.

8

23

17W

WELL NO.

9 L. J. Schartz

FARM

COMPANY

Hilton Drlg. etal.

CONTRACTOR

CORRECTION


SW NE NE

990 FT. FROM N. LINE

FT. FROM S. LINE

990 FT. FORM E. LINE

FT. FROM W. LINE

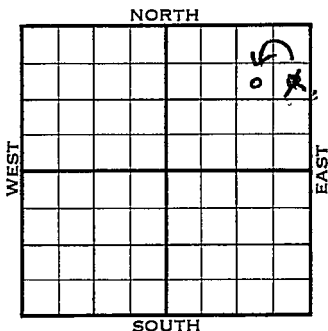

Pawnee County

☐

LOCATION

☐

RIG UP

DRILLING AND REMARKS:

Reported
SE NE NE

RECORD

CASED IN., FT.

SAND

GAS

OIL

TOTAL DEPTH

1ST 24 HRS. NAT.

1ST 24 HRS. AFTER SHOT

GAS CU. FT.

DRY HOLE

ABANDONED

PRODUCTION

DATE

SEP 28 1955

SCOUT

L. J. Harris

SCOUT TICKET

DX-201

SEC.

TWP.

R.

8

23

17W

WELL NO.

9 L. J. Schartz

FARM

COMPANY

Hilton Drlg. etal.

CONTRACTOR

CORRECTION

SW NE NE

990 FT. FROM N. LINE

FT. FROM S. LINE

990 FT. FORM E. LINE

FT. FROM W. LINE

NORTH

WEST

EAST

SOUTH

Pawnee County

☐

LOCATION

☐

RIG UP

DRILLING AND REMARKS:

Reported

SE NE NE

RECORD

CASED IN., FT.

SAND

GAS

OIL

TOTAL DEPTH

1ST 24 HRS. NAT.

1ST 24 HRS. AFTER SHOT

GAS CU. FT.

DRY HOLE

ABANDONED

PRODUCTION

DATE

SCOUT

NOV 23 1955

County Parmer Elev. 2082
 Sec. 8 Twp. 23 Rge. 17W
 Company Hilton Drlg.
 Farm Name D. J. Schartz No. 9

TOPS	DEPTH	LOG	DATUM	Loc. in Sec.
Anh.				SW NE NE
Tp.				
H.	<u>3627</u>		<u>1545</u>	
Tr.				
Dg.				
BL.	<u>3733</u>		<u>1651</u>	
L.	<u>3741</u>		<u>1659</u>	Geol.
K.C.				Contr.
B.K.C.				
Ce.				Co. tools
C. shly	<u>4156</u>		<u>2074</u>	
M. <u>cd</u>	<u>4167</u>		<u>2085</u>	
M. <u>chert</u>	<u>4187</u>		<u>2105</u>	Popl.
K. M. <u>ch</u>	<u>4198</u>		<u>2116</u>	<u>Garfield</u>
Mz. <u>sd</u>	<u>4239</u>		<u>2157</u>	
Mo.				
V.				
S.	<u>4268</u>		<u>2186</u>	
S.				
A.				
R.				
Pe.				COMPLETE
G.				
T.D.	<u>4283</u>			

Date Comm. 9-26-55 NOV 23 1955
8 5/8" @ 248/195 DST 4186-98 open 1 1/2 hr.
gas in 45 min. rec. 60' gcm 1100/30"
DST 4198-4214 gas to surface in 4 min.
open 35 min. oil to surface in 26 min.
1163/30" 5 1/2" @ 4281/400 CO 48/1200-08
frac S & F/ 15 bo 12 hr. S & F/ 13 bo
Comp. 328 bopd